

SURVEY & REMONUMENTATION

APR 28 1995

LINES 1810 PAGE 49

COMMISSION

LAND CORNER RECORDATION CERTIFICATE
Filing Requirement of Act 74, Mich. P.A. 1970

For corners in

<u>MUSKEGON</u> (County)	Located In:	Corner Code #
1. Public Land Survey	T <u>9N</u> R <u>15W</u>	<u>E-13</u>
	T _____ R _____	_____
	T _____ R _____	_____
2. Property Controlling in Section	S _____ T _____ R _____	_____
	S _____ T _____ R _____	_____
3. Miscellaneous Property in Sec.	S _____ T _____ R _____	_____
	S _____ T _____ R _____	_____

STATE OF MICHIGAN
 COUNTY OF MUSKEGON
 RECEIVED FOR RECORD
 1994 DEC 27 AM 11:42
 Register of Deeds Stamp & File Number
Allen Coakley
 REGISTER OF DEEDS
A1536

4. Lot No. _____, Recorded Plat _____
 5. Private Claims _____

A	B	C	D	E	F	G	H	I	J	K	L	M
2	6	5	4	3	2	1						
3												
4	7	8	9	10	11	12						
5												
6	16	17	16	15	14	13						
7												
8	19	20	21	22	23	24						
9												
10	30	29	28	27	26	25						
11												
12	31	32	33	34	35	36						
13												

STEPHEN V. VALLIER in a field survey on DECEMBER, 19 94, do hereby certify that under requirements of P.A. 74, Michigan P.A. of 1970, the corner points mentioned in lines 1 and 2 above were in conformance with regulations and rules therefore as required in the current manual of survey instructions of the United States Department of the Interior, Bureau of Land Management or by a decree of a Court of Law and/or that the corner points mentioned in lines 3, 4 and 5 above were in conformance with the rules of the Michigan Board of Land Surveyors or by a Decree of a Court of Law; established, re-established, monumented, re-monumented, recovered, found as expressed below:

NOTE: Not more than 4 corners, all in the same town and range, may be recorded on this certificate.

A. Description of original monument and accessories and/or subsequent restoration:

1837 GLO SET SECTION CORNER
 8" BEECH ON CORNER
 N 62° E 26 LINKS 15" PINE

1950'S M.C.R.C.
 SW 43.2' 10" MAPLE
 NE NO DISTANCE 14" MAPLE
 NNW 44.50' 12" MAPLE

1973 J. SPENCER, LBR. 1023, PG. 570
 FOUND 1/2" IRON ROD
 N 60° W 111.32' P. POLE
 S 25° E 39.25' 10" APPLE
 S 10° W 32.87' 11" PINE
 S 65° W 71.94' 13" PINE
 S 34.95' 12" STUMP

1978 D. SCHIELE, LBR. 1134, PG. 261
 FOUND STEEL BAR IN MON. BOX
 NW 111.40' P. POLE
 SE 39.21' 10" APPLE
 SSW 32.83' 12" PINE
 WSW 71.96' 12" PINE

B. Description of corner evidence found and/or method applied in restoring or reestablishing corner:

FOUND 2 3/4" CAST IRON MONUMENT-ACCEPTED POSITION DUE TO CONSISTENT DOCUMENTATION
 NW 111.40' P. POLE
 SE 39.21' 10" APPLE
 SSW 32.83' 12" PINE
 WSW 71.96' 12" PINE


POSITION OF SAID
 RECORDED CORNER
 REVIEWED & RATIFIED
 BY MUSKEGON COUNTY
 PEER GROUP IN ACCORDANCE
 WITH P.A. 345, OF 1990

Aug 2, 1994 sw

C. Description of monument for corner and accessories established to perpetuate locating the position of the corner:

2 3/4" CAST IRON MONUMENT
 N 54° W 111.40' NAIL S. SIDE P. POLE
 S 58° W 79.78' NAIL S. SIDE 16" R. PINE
 S 50° W 48.19' NAIL N. SIDE 14" R. PINE
 S 15° W 32.83' NAIL W. SIDE 16" R. PINE
 S 22° E 39.14' NAIL W. SIDE 12" APPLE
 S 60° E 84.36' NAIL N. SIDE 14" APPLE

Signed by *Stephen Vallier*
 Surveyor's Michigan License No. 28428

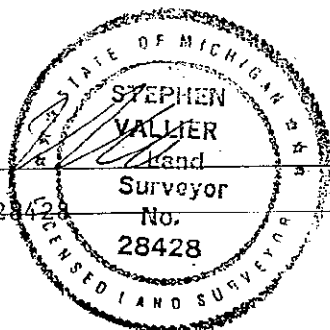

Date *Dec 27, 1994*