

COMMISSION

LAND CORNER RECORDATION CERTIFICATE  
Filing Requirement of Act 74, Mich. P.A. 1970

For corners in

MUSKEGON	Located In:	Corner Code #
(County)		
1. Public Land Survey	T 9N R 15W	F-6
	T R	
	T R	
	T R	
2. Property Controlling in Section	S T R	
	S T R	
3. Miscellaneous Property in Sec.	S T R	
	S T R	

*Carrie Carter*  
REGISTER OF DEEDS

Register of Deeds Stamp & File Number

- 4. Lot No. \_\_\_\_\_, Recorded Plat \_\_\_\_\_
- 5. Private Claims \_\_\_\_\_

	A	B	C	D	E	F	G	H	I	J	K	L	M
2	6		5		4		3		2		1		
3													
4	7		8		9		10		11		12		
5													
7													
8	19		20		21		22		23		24		
9													
10	30		29		28		27		26		25		
11													
12	31		32		33		34		35		36		
13													

STEPHEN V. VALLIER, in a field survey on NOVEMBER 24, 1993, do hereby certify that under requirements of P.A. 74, Michigan P.A. of 1970, the corner points mentioned in lines 1 and 2 above were in conformance with regulations and rules therefore as required in the current manual of survey instructions of the United States Department of the Interior, Bureau of Land Management or by a decree of a Court of Law and/or that the corner points mentioned in lines 3, 4 and 5 above were in conformance with the rules of the Michigan Board of Land Surveyors or by a Decree of a Court of Law; established, re-established, monumented, re-monumented, recovered, found as expressed below:

NOTE: Not more than 4 corners, all in the same town and range, may be recorded on this certificate.

A. Description of original monument and accessories and/or subsequent restoration:  
CORNER NOT SET BY G.L.O.

1/2" IRON ROD SET BY C.F. LEWANDOWSKI

S 38°E	S 25° W	N 85° W	N 25°E	EAST
33.94'	42.85'	38.79'	17.88'	23'±
10" TW. CHERRY	8" MAPLE CLUSTER	6" TW. MAPLE	20" B. OAK	N-S FENCE

B. Description of corner evidence found and/or method applied in restoring or reestablishing corner:  
FOUND 1/2" IRON ROD

S 38° E	S 25° W	N 85° W	N 25° E
33.94'	42.82'	38.78'	17.88'
6" TW. CHERRY	MAPLE CLUSTER	8" MAPLE (DEAD)	22" OAK


HISTORICAL USAGE, DOCUMENTATION & EVIDENCE OF CORNER LOCATION REVIEWED & RATIFIED BY MUSKEGON COUNTY PEER GROUP NOV. 2, 1993. CORNER SET BY C.F. LEWANDOWSKI AT INTERSECTION OF 1/4 LINES.

C. Description of monument for corner and accessories established to perpetuate locating the position of the corner:  
SET 4" X 30" CAST IRON MONUMENT WITH COUNTY SURVEY CAP (REPLACED 1/2" IRON ROD)

S 38° E	S 25° W	N 81° W	N 70°W	N 30° E	N 60° E
33.94'	42.82'	38.78'	15.55'	17.88'	61.78'
6" TW. CHERRY (FOUND NAIL E'LY SIDE)	MAPLE CLUSTER (FOUND NAIL SE'LY SIDE)	8" MAPLE (DEAD) (FOUND NAIL N'LY SIDE)	6" OAK (SET NAIL S'LY SIDE)	22" OAK (FOUND NAIL W'LY SIDE)	16" TW. OAK (SET NAIL S'LY SIDE)

Signed by STEPHEN V. VALLIER

Surveyor's Michigan License No. 28428

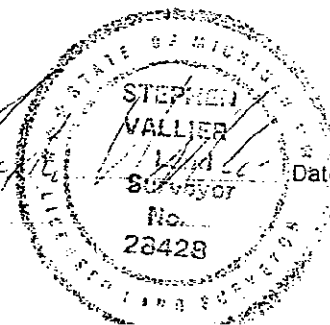

Date Dec 28, 1993