

APR 28 1995

LAND CORNER RECORDATION CERTIFICATE  
Filing Requirement of Act 74, Mich. P.A. 1970

For corners in  
**COMMISSION**  
MUSKEGON  
(County)

Located In: Corner Code #

- 1. Public Land Survey T 9N R 15W F-10
- T \_\_\_\_\_ R \_\_\_\_\_
- T \_\_\_\_\_ R \_\_\_\_\_
- T \_\_\_\_\_ R \_\_\_\_\_
- 2. Property Controlling S \_\_\_\_\_ T \_\_\_\_\_ R \_\_\_\_\_
- in Section S \_\_\_\_\_ T \_\_\_\_\_ R \_\_\_\_\_
- 3. Miscellaneous S \_\_\_\_\_ T \_\_\_\_\_ R \_\_\_\_\_
- Property in Sec. S \_\_\_\_\_ T \_\_\_\_\_ R \_\_\_\_\_

A1548

*Carrie Carter*  
REGISTER OF DEEDS

1994 DEC 27 AM 11:42

STATE OF MICHIGAN  
COUNTY OF MUSKEGON  
RECEIVED FOR RECORD

Register of Deeds Stamp & File Number

- 4. Lot No. \_\_\_\_\_, Recorded Plat \_\_\_\_\_
- 5. Private Claims \_\_\_\_\_

	A	B	C	D	E	F	G	H	I	J	K	L	M
2	6	5	4	3	2	1							
3													
4	7	8	9	10	11	12							
5													
6	18	17	16	15	14	13							
7													
8	19	20	21	22	23	24							
9													
10	30	29	28	27	26	25							
11													
12	31	32	33	34	35	36							
13													

I, STEPHEN V. VALLIER in a field survey on DECEMBER, 19 94, do hereby certify that under requirements of P.A. 74, Michigan P.A. of 1970, the corner points mentioned in lines 1 and 2 above were in conformance with regulations and rules therefore as required in the current manual of survey instructions of the United States Department of the Interior, Bureau of Land Management or by a decree of a Court of Law and/or that the corner points mentioned in lines 3, 4 and 5 above were in conformance with the rules of the Michigan Board of Land Surveyors or by a Decree of a Court of Law; established, re-established, monumented, re-monumented, recovered, found as expressed below:


NOTE: Not more than 4 corners, all in the same town and range, may be recorded on this certificate.

A. Description of original monument and accessories and/or subsequent restoration:  
CORNER NOT SET GLO

1972 C.F. LEWANDOWSKI FOUND 1/2" IRON ROD  
FIT LOCATION FOR INTERSECTION - ALSO USED IN 1977.  
SW 63.36' 8" ASPEN  
SSE 40.25' 5" ASPEN  
NE 38.30' FENCE POST

B. Description of corner evidence found and/or method applied in restoring or reestablishing corner:

FOUND 5/8" ROD - ACCEPTED POSITION OF CORNER - ORIGIN UNKNOWN BUT IT APPEARS CORNER IS CONSISTENT WITH HISTORICAL USAGE, OCCUPATION, AND KNOWN DOCUMENTS  
NE 38.30' FENCE POST

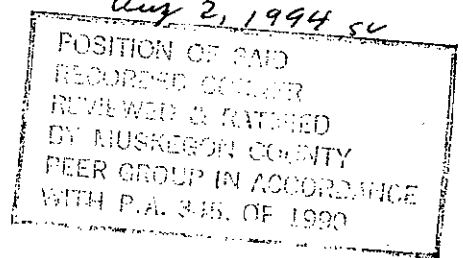


C. Description of monument for corner and accessories established to perpetuate locating the position of the corner:

SET 4" X 30" CAST IRON MONUMENT WITH COUNTY SURVEY CAP - REPLACE 5/8" ROD

N 35° E 38.37' NAIL E. SIDE FENCE POST  
N 40° W 55.34' NAIL SW SIDE 8" ASPEN  
S 5° W 34.11' NAIL E. SIDE CORNER FENCE POST  
S 55° E 58.46' NAIL N. SIDE 6" TWIN OAK

Signed by \_\_\_\_\_  
Surveyor's Michigan License No. 28428 No. 28428

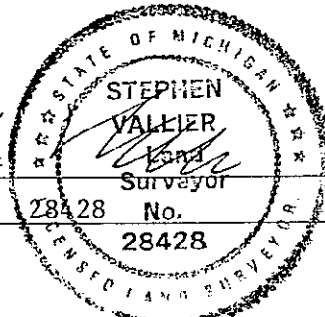

Date Dec 27 1994