

REMONUMENTATION

LAND CORNER RECORDATION CERTIFICATE

Filing Requirement of Act 74, Mich. P.A. 1970

APR 28 1995

For corners in

MUSKEGON COMMISSION Located In:

Corner Code #

- 1. Public Land Survey T 9N R R15W F-11
- T _____ R _____
- T _____ R _____
- T _____ R _____
- 2. Property Controlling S _____ T _____ R _____
- in Section S _____ T _____ R _____
- 3. Miscellaneous S _____ T _____ R _____
- Property in Sec. S _____ T _____ R _____

A1549

STATE OF MICHIGAN
COUNTY OF MUSKEGON
REGISTERED FOR RECORD
1991 DEC 27 AM 11:42
Doris Carter
REGISTER OF DEEDS
Register of Deeds Stamp & File Number

- 4. Lot No. _____, Recorded Plat _____
- 5. Private Claims _____

	A	B	C	D	E	F	G	H	I	J	K	L	M
2	6	5	4	3	2	1							
3													
4	7	8	9	10	11	12							
5													
6	18	17	16	15	14	13							
7													
8	19	20	21	22	23	24							
9													
10	30	29	28	27	26	25							
11													
12	31	32	33	34	35	36							
13													

I, STEPHEN V. VALLIER, in a field survey on DECEMBER, 19 94, do hereby certify that under requirements of P.A. 74, Michigan P.A. of 1970, the corner points mentioned in lines 1 and 2 above were in conformance with regulations and rules therefore as required in the current manual of survey instructions of the United States Department of the Interior, Bureau of Land Management or by a decree of a Court of Law and/or that the corner points mentioned in lines 3, 4 and 5 above were in conformance with the rules of the Michigan Board of Land Surveyors or by a Decree of a Court of Law; established, re-established, monumented, re-monumented, recovered, found as expressed below:

NOTE: Not more than 4 corners, all in the same town and range, may be recorded on this certificate.

A. Description of original monument and accessories and/or subsequent restoration:

- 1837 CORNER SET BY GLO
- S 28° W 28 LINKS 10" BEECH
- N 12° E 15 LINKS 11" BEACH
- 1978 LBR. 1134, PG. 262
- S 57° W 8" SASSAFRAS 61.93'
- N 5° W TWIN OAK 71.00'
- S 48° E 10" BIRCH 63.20'
- N P. POLE 45.40'
- N 4" TWIN CHERRY 40.85'

1950 M.C.R.C. Railroad Spike

B. Description of corner evidence found and/or method applied in restoring or reestablishing corner:


FOUND COUNTY SURVEY MONUMENT - ACCEPTED POSITION OF CORNER HISTORICAL USAGE AND DOCUMENTATION

Aug 2, 1994
POSITION OF SAID RECORDED CORNER REVIEWED & RATIFIED BY MUSKEGON COUNTY PEER GROUP IN ACCORDANCE WITH P.A. 345, OF 1990

C. Description of monument for corner and accessories established to perpetuate locating the position of the corner:

- FOUND CAST IRON MONUMENT 4" WITH COUNTY SURVEY CAP
- S 52° W 61.97 NAIL S. SIDE 8" SASSAFRAS
- S 45° W 43.58' NAIL S. SIDE G. POLE
- S 5° E 37.63' NAIL W. SIDE 16" ASPEN
- S 48° E 62.99' NAIL N. SIDE 12" WHITE PINE
- N 4° E 45.82' NAIL W. SIDE P. POLE
- N 6° W 71.00' NAIL W. SIDE 14" TWIN OAK
- N 36° W 81.13' NAIL S. SIDE 10" OAK

Signed by Stephen Vallier
Surveyor's Michigan License No. 28428

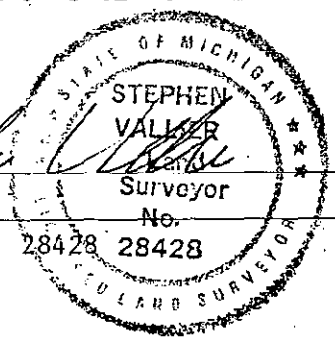

Date Nov. 1994