

APR 28 1995

LAND CORNER RECORDATION CERTIFICATE  
Filing Requirement of Act 74, Mich. P.A. 1970

For corners in **COMMISSION**

<u>MUSKEGON</u> (County)	Located In:	Corner Code #
1. Public Land Survey	T 9N R 15W	F-13
	T R	
	T R	
	T R	
2. Property Controlling in Section	S T R	
	S T R	
3. Miscellaneous Property in Sec.	S T R	
	S T R	

A1550

STATE OF MICHIGAN  
COUNTY OF MUSKEGON  
RECEIVED FOR RECORD  
1994 DEC 27 AM 11:42  
Darius Carter  
REGISTER OF DEEDS

Register of Deeds Stamp & File Number

4. Lot No. \_\_\_\_\_, Recorded Plat \_\_\_\_\_  
5. Private Claims \_\_\_\_\_

	A	B	C	D	E	F	G	H	I	J	K	L	M
2	6		5		4		3		2		1		
3													
4	7		8		9		10		11		12		
5													
6	18		17		16		15		14		13		
7													
8	19		20		21		22		23		24		
9													
10	30		29		28		27		26		25		
11													
12	31		32		33		34		35		36		
13													

I, STEPHEN V. VALLIER, in a field survey on DECEMBER, 1994, do hereby certify that under requirements of P.A. 74, Michigan P.A. of 1970, the corner points mentioned in lines 1 and 2 above were in conformance with regulations and rules therefore as required in the current manual of survey instructions of the United States Department of the Interior, Bureau of Land Management or by a decree of a Court of Law and/or that the corner points mentioned in lines 3, 4 and 5 above were in conformance with the rules of the Michigan Board of Land Surveyors or by a Decree of a Court of Law; established, re-established, monumented, re-monumented, recovered, found as expressed below:

**NOTE: Not more than 4 corners, all in the same town and range, may be recorded on this certificate.**

A. Description of original monument and accessories and/or subsequent restoration:

1837 GLO SET 1/4 POST  
N 89° E 37 LINKS 13" BEECH  
N 45° W 22 LINKS 13" BEECH

1978 D. SCHIELE, LBR. 1134, PG. 261 FOUND 1/2" STEEL BAR IN MON. BOX NW 58.05' SE CORNER  
S 32.71' FENCE POST  
N 33.86' 10" PINE  
SW 40.90' T. POLE  
NW 70.58' SW CORNER HOUSE

B. Description of corner evidence found and/or method applied in restoring or reestablishing corner:


FOUND CAST IRON MONUMENT WITH COUNTY SURVEY CAP (2 3/4") IN MON. BOX (ALSO E-1, T8N, R15W)  
ACCEPTED POSITION DUE TO HISTORICAL USAGE AND DOCUMENTATION

Aug 2, 1994 SW  
POSITION OF SAID RECORDED CORNER REVIEWED & RATIFIED BY MUSKEGON COUNTY PRER GROUP IN ACCORDANCE WITH P.A. 345, OF 1990

C. Description of monument for corner and accessories established to perpetuate locating the position of the corner:

2 3/4" CAST IRON MON. WITH COUNTY SURVEY CAP IN MON. BOX  
S 50° W 42.30' NAIL W. SIDE 6" ASPEN  
S 12° W 48.66' NAIL N. SIDE P. POLE  
N 33.97' NAIL W. SIDE 12" R. PINE  
N 52° W 59.23' NAIL S. SIDE 28" MAPLE  
N 15° W 58.86' SE CORNER HOUSE #6000  
N 65° E 61.04' NAIL S. SIDE 8" R. PINE

Signed by Stephen Vallier  
Surveyor's Michigan License No. 28428  
No. 28428

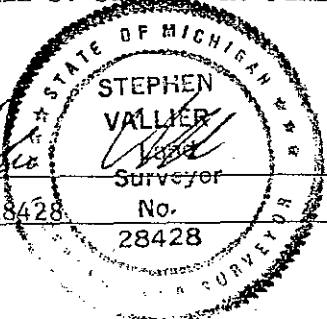

Date Dec 27, 1994