

1893

LIBER 1744 PAGE 560

STATE OF MICHIGAN
COUNTY OF MUSKEGON
RECEIVED FOR RECORD

1993 DEC 29 PM 4:02

Carrie Carter
REGISTER OF DEEDS


LAND CORNER RECORDATION CERTIFICATE
Filing Requirement of Act 74, Mich. P.A. 1970

For corners in

| | | |
|---------------------------------------|-------------|-----------------|
| MUSKEGON <small>(County)</small> | Located in: | Corner Code #/: |
| 1. Public Land Survey | T 9N R 15W | G-3 |
| | T R | |
| | T R | |
| | T R | |
| 2. Property Controlling in Section | S T R | |
| | S T R | |
| 3. Miscellaneous Property in Sec. | S T R | |
| | S T R | |

Register of Deeds Stamp & File Number

- 4. Lot No. _____, Recorded Plat _____
- 5. Private Claims _____

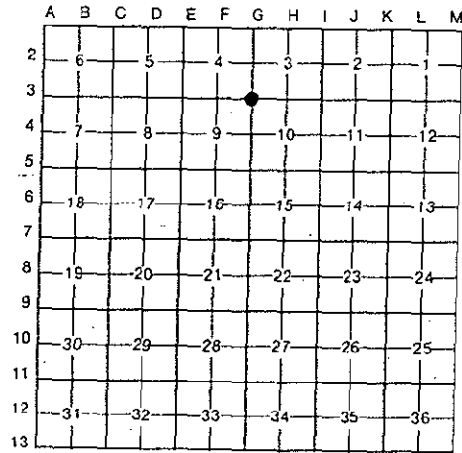

I, STEPHEN V. VALLIER in a field survey on NOVEMBER 22, 1993
do hereby certify that under requirements of P.A. 74, Michigan P.A. of 1970, the corner points mentioned in lines 1 and 2 above were in conformance with regulations and rules therefore as required in the current manual of survey instructions of the United States Department of the Interior, Bureau of Land Management or by a decree of a Court of Law and/or that the corner points mentioned in lines 3, 4 and 5 above were in conformance with the rules of the Michigan Board of Land Surveyors or by a Decree of a Court of Law; established, re-established, monumented, re-monumented, recovered, found as expressed below:

NOTE: Not more than 4 corners, all in the same town and range, may be recorded on this certificate.

A. Description of original monument and accessories and/or subsequent restoration:

GLO CORNER SET BY J. MULLETT, MAY 2, 1837
6" HEMLOCK AT CORNER
S 41° W
8 LINKS
6" BEECH

5/8" IRON ROD IN MONUMENT BOX
MUSKEGON COUNTY R.C., JULY 1976, RECORDED
IN LIB. 1087, PG. 689
SW NW SE SSW
83.75' 58.75' 65.44' 77.66'
9" & 10" P.P. 36" OAK 8" PINE
TWIN OAK

IRON PIPE -M.C.R.C.-1955
NE SE
102.30' 65.05'
10" W. OAK 10" W. OAK

B. Description of corner evidence found and/or method applied in restoring or reestablishing corner:

FOUND 5/8 IRON ROD IN MONUMENT BOX
S 73° W N 55° W S 50° E
83.65' 57.84' 65.44'
10" TWIN OAK P.P. 30" TWIN OAK

HISTORICAL USAGE, DOCUMENTATION & EVIDENCE OF CORNER LOCATION REVIEWED AND RATIFIED BY MUSKEGON COUNTY PEER GROUP JUNE 1, 1993

C. Description of monument for corner and accessories established to perpetuate locating the position of the corner:

SET 2 3/4" X 20" CAST IRON MONUMENT WITH COUNTY SURVEY CAP IN MONUMENT BOX (REPLACED 5/8" IRON ROD RECORDED IN LIBER 1087, PAGE 689)

| | | | | | |
|--------------|------------|-------------|-------------|------------|------------|
| S 73° W | N 55° W | S 50° E | S 49° W | N 79° E | N |
| 83.65' | 57.84' | 65.44' | 41.08' | 129.23' | 32.98' |
| 10" TWIN OAK | P. POLE | 30" TW. OAK | LT. POLE | P. POLE | FD. CAPPED |
| (FD. NAIL | (FD. NAIL | (FD. NAIL | (SET NAIL | (FD. NAIL | IRON ROD |
| N'LY SIDE) | N'LY SIDE) | S'LY SIDE) | NE'LY SIDE) | S'LY SIDE) | |

Signed by STEPHEN V. VALLIER

Date Dec 28, 1993

Surveyor's Michigan License No. 28428

