

COMMISSION LAND CORNER RECORDATION CERTIFICATE

Filing Requirement of Act 74, Mich. P.A. 1970

For corners in

MUSKEGON (County) Located In: Corner Code //

- 1. Public Land Survey T 9N R 15W G-6  
T R  
T R  
T R
- 2. Property Controlling S T R  
in Section S T R
- 3. Miscellaneous S T R  
Property in Sec. S T R

- 4. Lot No. , Recorded Plat
- 5. Private Claims

*Carrie Carter*  
REGISTER OF DEEDS

Register of Deeds Stamp & File Number

	A	B	C	D	E	F	G	H	I	J	K	L	M
2	6		5		4		3		2		1		
3													
4	7		8		9		10		11		12		
5													
6	16		17		16		15		14		13		
7													
8	19		20		21		22		23		24		
9													
10	30		29		28		27		26		25		
11													
12	31		32		33		34		35		36		
13													

I. STEPHEN V. VALLIER in a field survey on SEPTEMBER 20 1993

do hereby certify that under requirements of P.A. 74, Michigan P.A. of 1970, the corner points mentioned in lines 1 and 2 above were in conformance with regulations and rules therefore as required in the current manual of survey instructions of the United States Department of the Interior, Bureau of Land Management or by a decree of a Court of Law and/or that the corner points mentioned in lines 3, 4 and 5 above were in conformance with the rules of the Michigan Board of Land Surveyors or by a Decree of a Court of Law, established, re-established, monumented, re-monumented, recovered, found as expressed below:

NOTE: Not more than 4 corners, all in the same town and range, may be recorded on this certificate.

A. Description of original monument and accessories and/or subsequent restoration:

GLO CORNER SET BY J. MULLETT, 5-2-1837  
S 27° E S 66° W  
7 LINKS 13 LINKS  
15" HEMLOCK 6" BEECH

FOUND 1/2" IRON PIPE-J. CAMPBELL, JAN. 1980  
RECORDED IN LBR. 1188, PG. 209  
SE NE SE  
46.34' 57.41' 77.23'  
LT. POLE T. POLE 10" PINE

IRON PIPE-M.C.R.C. 1955  
NE SSE  
68.4' 78.98'  
18" MAPLE 8" LOCUST

WESTSHORE ENG. & SURVEYING, 4/91-FD. 1" IRON PIPE  
S 63°W N 33°W N 56°E S 41° E  
84.17' 49.46' 68.65' 48.26'  
NE COR. S END 30" MAP. P. POLE  
POLE BARN CMP CULVERT

OVER-SEE REVERSE SIDE :

B. Description of corner evidence found and/or method applied in restoring or reestablishing corner:

FOUND 1" X 22" IRON PIPE OVER A 1/2" X 24" ROD-PHYSICAL MONUMENT DIFFERENT THAN MONUMENT RECORDED IN LBR. 1188, PG. 209-1955 MEAS. OF M.C.R.C. 2640.0 COMPARES TO WESTSHORE MEAS. OF 1991 2640.39'.

NOTE: RECORDED LAND CORNER RECORDATION (LBR. 1188, PG. 209) HAS A QUESTION MARK ADJACENT TO CORNER G-6. LABELED G-8 HANDWRITTEN ALONGSIDE. S 41° E 48.26' P. POLE


HISTORICAL USAGE, DOCUMENTATION & EVIDENCE OF SECTION 15, AND SECTION 16 REVIEWED BY MUSKEGON COUNTY PEER GROUP. CORNER POSITION RATIFIED ON AUG. 4, 1993

C. Description of monument for corner and accessories established to perpetuate locating the position of the corner:

SET 4" X 30" CAST IRON MONUMENT WITH OCUNTY SURVEY CAP (REPLACED 1" X 22" IRON PIPE)

S 63°W	N 33°W	N 56°E	S 41°E	S 85°E	N 40°E
84.17'	49.46'	68.65'	48.26'	75.69'	60.28'
NE COR	"X"	30" MAP.	P. POLE	T. POLE	12" PINE
METAL	CHISELED	(FD. NAIL	(FD. NAIL	(SET NAIL	(SET NAIL)
BLDG.	IN W. END	IN NE'LY	E SIDE)	N'LY SIDE)	
	OF 12" RCP	SIDE)			
	CULVERT				

Signed by STEPHEN V. VALLIER  
Surveyor's Michigan License No. 28428

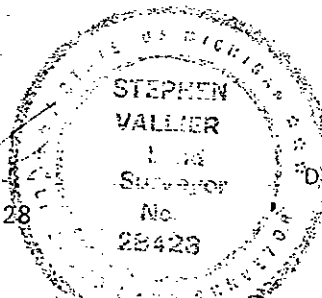

SECTION "A" CONTINUED:

G-6 1" IRON PIPE-D. SCHIELE-JAN. 1992 RECORDED IN LBR. 1605, PG. 406

NNE	NE	SE	WSW
60.10'	68.67'	45.75'	84.24'
12" WHITE	28" MAP.	T. PEDESTAL	NE COR. BLDG.
PINE			