

**SURVEY &  
REMONUMENTATION**

LIBER **1810** PAGE **568**

STATE OF MICHIGAN  
COUNTY OF MUSKEGON  
RECEIVED FOR RECORD

APR 28 1995

**LAND CORNER RECORDATION CERTIFICATE**  
Filing Requirement of Act 74, Mich. P.A. 1970

1994 DEC 29 AM 10:13

**COMMISSION**

*Carrie Carter*  
REGISTER OF DEEDS

For corners in

<u>Muskegon</u> (County)	Located In:	Corner Code #
1. Public Land Survey	T <u>9</u> R <u>15</u>	<u>G-9</u>
	T _____ R _____	_____
	T _____ R _____	_____
	T _____ R _____	_____
2. Property Controlling in Section	S _____ T _____ R _____	_____
	S _____ T _____ R _____	_____
3. Miscellaneous Property in Sec.	S _____ T _____ R _____	_____
	S _____ T _____ R _____	_____

*A1592*

Register of Deeds Stamp & File Number

4. Lot No. \_\_\_\_\_, Recorded Plat \_\_\_\_\_  
5. Private Claims \_\_\_\_\_

A	B	C	D	E	F	G	H	I	J	K	L	M
2	6	5	4	3	2	1						
3												
4	7	8	9	10	11	12						
5												
6	18	17	16	15	14	13						
7												
8	19	20	21	22	23	24						
9												
10	30	29	28	27	26	25						
11												
12	31	32	33	34	35	36						
13												

I, Stephen V. Vallier, in a field survey on July, 1994, do hereby certify that under requirements of P.A. 74, Michigan P.A. of 1970, the corner points mentioned in lines 1 and 2 above were in conformance with regulations and rules therefore as required in the current manual of survey instructions of the United States Department of the Interior, Bureau of Land Management or by a decree of a Court of Law and/or that the corner points mentioned in lines 3, 4 and 5 above were in conformance with the rules of the Michigan Board of Land Surveyors or by a Decree of a Court of Law; established, re-established, monumented, re-monumented, recovered, found as expressed below:

**NOTE: Not more than 4 corners, all in the same town and range, may be recorded on this certificate.**

A. Description of original monument and accessories and/or subsequent restoration:

- 1837 GLO set section corner
- 1950's M.C.R.C. (witnesses only)
- 1979 J. Campbell (recorded survey) Liber 1188 Page 208 Found 3" pipe.
- 1984 C.F. Lewandowski Liber 1297 Page 935 Found 2 1/2" iron pipe.  
Reset with 4" x 30" cast iron monument with cap.

B. Description of corner evidence found and/or method applied in restoring or reestablishing corner:


Found 4" cast iron monument with County Survey Cap - Accepted position of corner due to historical usage and documentation.

POSITION OF SAID  
RECORDED CORNER  
REVIEWED & RATIFIED  
BY MUSKEGON COUNTY  
FEER GROUP IN ACCORDANCE  
WITH P.A. 345, OF 1990  
*July 5 1994 SW*

C. Description of monument for corner and accessories established to perpetuate locating the position of the corner:

4" cast iron monument with County Survey Cap.

- N 55 deg E 45.10' 12" Pine with nail
- S 60 deg E 41.76' 12" Pine with nail
- S 80 deg W 31.52' 8" Basswood with nail
- N 65 deg W 115.93' Southeast corner cap

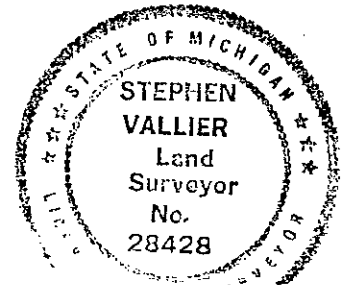

Signed by *Stephen Vallier* Date *Dec 27, 1994*  
Surveyor's Michigan License No. 28428