

**SURVEY &
REMONUMENTATION**

LIBER 1810 PAGE 569

STATE OF MICHIGAN
COUNTY OF MUSKEGON
RECEIVED FOR RECORD

APR 28 1995

LAND CORNER RECORDATION CERTIFICATE
Filing Requirement of Act 74, Mich. P.A. 1970

1994 DEC 29 AM 10:14

For corners in

COMMISSION

Carris Carter
REGISTER OF DEEDS

Muskegon (County) Located In: _____ Corner Code # _____

1. Public Land Survey	T <u>9</u> R <u>15</u>	G-10
	T _____ R _____	_____
	T _____ R _____	_____
	T _____ R _____	_____
2. Property Controlling in Section	S _____ T _____ R _____	_____
	S _____ T _____ R _____	_____
3. Miscellaneous Property in Sec.	S _____ T _____ R _____	_____
	S _____ T _____ R _____	_____

A 1593

Register of Deeds Stamp & File Number

4. Lot No. _____, Recorded Plat _____
5. Private Claims _____

A	B	C	D	E	F	G	H	I	J	K	L	M
2	6	5	4	3	2	1						
3												
4	7	8	9	10	11	12						
5												
6	18	17	16	15	14	13						
7												
8	19	20	21	22	23	24						
9												
10	30	29	28	27	26	25						
11												
12	31	32	33	34	35	36						
13												

I, Stephen V. Vallier, in a field survey on July, 1994, do hereby certify that under requirements of P.A. 74, Michigan P.A. of 1970, the corner points mentioned in lines 1 and 2 above were in conformance with regulations and rules therefore as required in the current manual of survey instructions of the United States Department of the Interior, Bureau of Land Management or by a decree of a Court of Law and/or that the corner points mentioned in lines 3, 4 and 5 above were in conformance with the rules of the Michigan Board of Land Surveyors or by a Decree of a Court of Law; established, re-established, monumented, re-monumented, recovered, found as expressed below:

NOTE: Not more than 4 corners, all in the same town and range, may be recorded on this certificate.

A. Description of original monument and accessories and/or subsequent restoration:

- 1837 GLO set 1/4 corner.
- 1950's M.C.R.C. tie map (witnesses only)
- 1972 Liber 979 Page 344 Iron
- 1990 Westshore Engineering Liber 1549 Page 567 Found 3/4" x 18" solid iron Reset 2 3/4" x 30" cast iron monument with County Survey Cap.

B. Description of corner evidence found and/or method applied in restoring or reestablishing corner:

Found 2 3/4" cast iron monument with County Survey Cap. Also found 1" iron pipe 6.8' West and 1.6' North. Accepted position of cast iron monument as corner due to historical usage and documentation


POSITION OF SAID
RECORDED CORNER
REVIEWED & RATIFIED
BY MUSKEGON COUNTY
PEER GROUP IN ACCORDANCE
WITH P.A. 345, OF 1990

July 5 1994 su

C. Description of monument for corner and accessories established to perpetuate locating the position of the corner:

2 3/4" cast iron monument with County Survey Cap.

- N 44 deg E 20.93' Light Pole with nail
- N 48 deg E 56.93' 14" White Pine with nail
- S 37 deg W 83.79' 36" Maple with nail
- S 67 deg W 86.45' Power Pole with nail
- N 45 deg W 73.90' 14" White Pine with nail
- N 80 deg W 6.90' 1" pipe

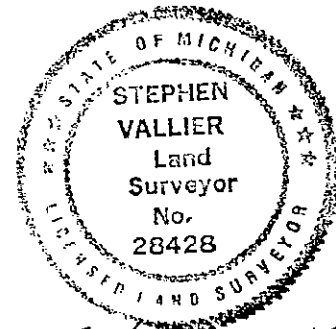

Signed by *Stephen V. Vallier*

Date *July 5 1994*

Surveyor's Michigan License No. 28428