

APR 28 1995

LAND CORNER RECORDATION CERTIFICATE
Filing Requirement of Act 74, Mich. P.A. 1970

For corners in COMMISSION

| | | |
|---------------------------------------|--------------------------|---------------|
| MUSKEGON <small>(County)</small> | Located In: | Corner Code # |
| 1. Public Land Survey | T <u>9N</u> R <u>15W</u> | <u>G-12</u> |
| | T _____ R _____ | _____ |
| | T _____ R _____ | _____ |
| | T _____ R _____ | _____ |
| 2. Property Controlling in Section | S _____ T _____ R _____ | _____ |
| | S _____ T _____ R _____ | _____ |
| 3. Miscellaneous Property in Sec. | S _____ T _____ R _____ | _____ |
| | S _____ T _____ R _____ | _____ |

A 1344

STATE OF MICHIGAN
COUNTY OF MUSKEGON
REGISTER OF DEEDS
1994 DEC 27 AM 11:41
Cassie Carter
REGISTER OF DEEDS

Register of Deeds Stamp & File Number

4. Lot No. _____, Recorded Plat _____
5. Private Claims _____

I, STEPHEN V. VALLIER, in a field survey on JULY, 19 94, do hereby certify that under requirements of P.A. 74, Michigan P.A. of 1970, the corner points mentioned in lines 1 and 2 above were in conformance with regulations and rules therefore as required in the current manual of survey instructions of the United States Department of the Interior, Bureau of Land Management or by a decree of a Court of Law and/or that the corner points mentioned in lines 3, 4 and 5 above were in conformance with the rules of the Michigan Board of Land Surveyors or by a Decree of a Court of Law; established, re-established, monumented, re-monumented, recovered, found as expressed below:

| A | B | C | D | E | F | G | H | I | J | K | L | M |
|----|----|----|----|----|----|----|---|---|---|---|---|---|
| 2 | 6 | 5 | 4 | 3 | 2 | | | | | | | |
| 3 | | | | | | | | | | | | |
| 4 | 7 | 8 | 9 | 10 | 11 | 12 | | | | | | |
| 5 | | | | | | | | | | | | |
| 6 | 18 | 17 | 16 | 15 | 14 | 13 | | | | | | |
| 7 | | | | | | | | | | | | |
| 8 | 19 | 20 | 21 | 22 | 23 | 24 | | | | | | |
| 9 | | | | | | | | | | | | |
| 10 | 30 | 29 | 28 | 27 | 26 | 25 | | | | | | |
| 11 | | | | | | | | | | | | |
| 12 | 31 | 32 | 33 | 34 | 35 | 36 | | | | | | |
| 13 | | | | | | | | | | | | |

NOTE: Not more than 4 corners, all in the same town and range, may be recorded on this certificate.

A. Description of original monument and accessories and/or subsequent restoration:

| | |
|-------------------------------|---|
| 1837 GLO SET 1/4 CORNER | 1980 D. SCHIELE, LBR. 1199, PG. 517 FOUND STEEL |
| N 77° E 12 LINKS 12" HEMLOCK | BAR CAPPED #23517 OVER 1 1/2" IRON PIPE |
| S 4° W 12 LINKS 6" HEMLOCK | NE 130.37' SW CORN BLOCK SHED |
| | E 55.33' P. POLE |
| 1950'S M.C.R.C. 2" WOOD STAKE | W 29.50' P. POLE |
| NE 50.00' HUB | WNW 30.53' CORNER FENCE POST |
| SE 50.00' HUB | |

B. Description of corner evidence found and/or method applied in restoring or reestablishing corner:

FOUND 3/8" X 12" ROD OVER 1" X 48" IRON PIPE - ACCEPTED POSITION OF EXISTING CORNER. ORIGIN UNCERTAIN BUT APPEARS TO BE SET BY SINGLE PROPORTIONATE MEASURE. SECTIONAL INFORMATION CONSISTENT FOR LAST 50 YEARS.

N 49° E 130.37' SW CORNER BLOCK SHED
N 85° W 29.46' P. POLE
S 88° E 55.31' P. POLE


July 5, 1994
POSITION OF SAID RECORDED CORNER REVIEWED & RATIFIED BY MUSKEGON COUNTY PEER GROUP IN ACCORDANCE WITH P.A. 345, OF 1990

C. Description of monument for corner and accessories established to perpetuate locating the position of the corner:

RESET 3/8" X 12" ROD WITH 4" X 30" CAST IRON MONUMENT WITH COUNTY SURVEY CAP

| | |
|-----------------|---------------------------------|
| N 44° E 130.37' | SW CORNER BLOCK SHED |
| N 85° W 29.46' | NAIL IN P. POLE |
| S 88° E 55.31" | NAIL IN NORTH SIDE P. POLE |
| N 23° E 97.53' | NAIL IN EAST SIDE P. POLE |
| N 10° W 98.36' | NAIL IN E. SIDE COR. FENCE POST |

Signed by _____
Surveyor's Michigan License No. 28428

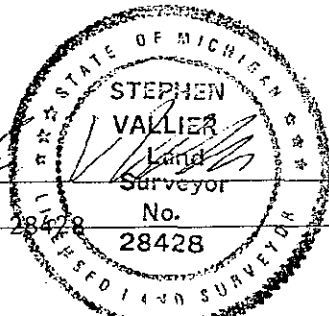

Date Dec 27, 1994