

SURVEY & REMONUMENTATION

LIBER **1810** PAGE **38**

APR 28 1995

LAND CORNER RECORDATION CERTIFICATE
Filing Requirement of Act 74, Mich. P.A. 1970

For corners in **COMMISSION**
MUSKEGON
(County)

Located In: Corner Code #

1. Public Land Survey	T <u>9N</u> R <u>15W</u>	<u>G-13</u>
	T _____ R _____	_____
	T _____ R _____	_____
	T _____ R _____	_____
2. Property Controlling in Section	S _____ T _____ R _____	_____
	S _____ T _____ R _____	_____
3. Miscellaneous Property in Sec.	S _____ T _____ R _____	_____
	S _____ T _____ R _____	_____

A1545

STATE OF MICHIGAN
COUNTY OF MUSKEGON
RECEIVED FOR RECORD
1994 DEC 27 AM 11:41
Colleen Carter
REGISTER OF DEEDS

Register of Deeds Stamp & File Number

4. Lot No. _____, Recorded Plat _____
5. Private Claims _____

A	B	C	D	E	F	G	H	I	J	K	L	M
2	6	5	4	3	2	1						
3												
4	7	8	9	10	11	12						
5												
6	18	17	16	15	14	13						
7												
8	19	20	21	22	23	24						
9												
10	30	29	28	27	26	25						
11												
12	31	32	33	34	35	36						
13												

I, STEPHEN V. VALLIER, in a field survey on _____, 19____, do hereby certify that under requirements of P.A. 74, Michigan P.A. of 1970, the corner points mentioned in lines 1 and 2 above were in conformance with regulations and rules therefore as required in the current manual of survey instructions of the United States Department of the Interior, Bureau of Land Management or by a decree of a Court of Law and/or that the corner points mentioned in lines 3, 4 and 5 above were in conformance with the rules of the Michigan Board of Land Surveyors or by a Decree of a Court of Law, established, re-established, monumented, re-monumented, recovered, found as expressed below:

NOTE: Not more than 4 corners, all in the same town and range, may be recorded on this certificate.

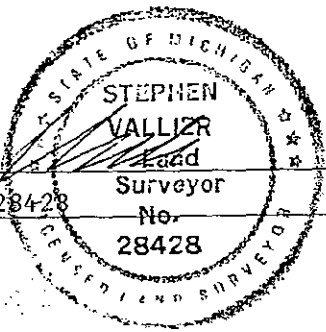
- A. Description of original monument and accessories and/or subsequent restoration:
- | | |
|----------------------------|------------------------------------|
| 1837 CORNER SET BY GLO | 1978 D. SCHIELE LBR. 1134, PG. 262 |
| 10" MAPLE ON CORNER | FOUND 3/8" STEEL BAR IN MON. BOX |
| N 45° W 12 LINKS 12" MAPLE | SE 71.12' 22" PINE |
| | SE 44.52' T. POLE |
| 1950'S M.C.R.C. IRON PIPE | NW 113.46' 20" ASH |
| SE 81.8' 8" APPLE | NE 129.85' 24" MAPLE |
| SW 28.0' T. POLE | |
| NW 85.7' 12" APPLE | |

- B. Description of corner evidence found and/or method applied in restoring or reestablishing corner:
FOUND 2 3/4" CAST IRON MON. WITH COUNTY SURVEY CAP IN MON. BOX
N 73° W 113.46' 22" ASH
ACCEPTED BY HISTORICAL DOCUMENTATION AND SECTIONAL MEASUREMENT ALONG SOUTH LINE OF TOWNSHIP

July 5, 1994 sw

POSITION OF SAID
RECORDED CORNER
REVIEWED & RATIFIED
BY MUSKEGON COUNTY
PEER GROUP IN ACCORDANCE
WITH P.A. 315, OF 1950

- C. Description of monument for corner and accessories established to perpetuate locating the position of the corner:
2 3/4" CAST IRON MONUMENT WITH COUNTY SURVEY CAP IN MON. BOX
N 43° E 54.26" NAIL IN N. SIDE 12" W. PINE
S 35° E 94.58" NAIL IN S. SIDE P. POLE
S 35° W 93.92' NAIL IN N SIDE 6" R. PINE
N 35° W 51.37" NAIL IN N SIDE OF 20" W. PINE
N 73° W 113.46' NAIL IN S. SIDE 22" ASH

Signed by *[Signature]*
Surveyor's Michigan License No. 28428


Date Dec 27, 1994