

1993

1993 DEC 29 PM 4:02

CONSULT

LAND CORNER RECORDATION CERTIFICATE  
Filing Requirement of Act 74, Mich. P.A. 1970

*Carrie Carter*  
REGISTER OF DEEDS

For corners in  
MUSKEGON

Located In: Corner Code #/

1. Public Land Survey

T 9N R 15W H-7

2. Property Controlling  
in Section

S T R  
S T R

3. Miscellaneous  
Property in Sec.

S T R  
S T R

4. Lot No. \_\_\_\_\_, Recorded Plat \_\_\_\_\_

5. Private Claims

Register of Deeds Stamp & File Number

I, **STEPHEN V. VALLIER**, in a field survey on **NOVEMBER 29**, 19 **93**  
do hereby certify that under requirements of P.A. 74, Michigan P.A. of 1970, the corner points mentioned  
in lines 1 and 2 above were in conformance with regulations and rules therefore as required in the  
current manual of survey instructions of the United States Department of the Interior, Bureau of Land  
Management or by a decree of a Court of Law and/or that the corner points mentioned in lines 3, 4 and 5  
above were in conformance with the rules of the Michigan Board of Land Surveyors or by a Decree of a  
Court of Law; established, re-established, monumented, re-monumented, recovered, found as  
expressed below:

A	B	C	D	E	F	G	H	I	J	K	L	A
2	6	5	4	3	2	1						
3												
4	7	8	9	10	11	12						
5												
6	18	17	16	15	14	13						
7												
8	19	20	21	22	23	24						
9												
10	30	29	28	27	26	25						
11												
12	31	32	33	34	35	36						
13												

**NOTE: Not more than 4 corners, all in the same town and range, may be recorded on this certificate.**

A. Description of original monument and accessories and/or subsequent restoration:

GLO CORNER SET BY J. MULLETT, 5-1-1837

S 20°W            N 22°W  
14 LINKS        24 LINKS  
8" HEMLOCK    12" HEMLOCK

FD. 1" PIPE-J. CAMPBELL-JAN 1980

(RECORDED LBR. 1188, PG. 210)  
N 70°E    S 70°E    N 15°W  
40.51'    45.35'    47.55'  
20" MAP.    12" TW. MAP.    30" BEECH

IRON -M.C.R.C.-DATE NOT KNOWN

NNW            NW            NNE  
10.82'        4.47'        11.74'  
10" PINE    10" PINE    10" PINE

B. Description of corner evidence found and/or method applied in restoring or reestablishing corner:

FOUND 1/2" IRON ROD, 24" IN LENGTH  
N 35°W            N 76°E  
4.45'            11.75'  
12" R. PINE    12" R. PINE


HISTORICAL USAGE, DOCUMENTATION & EVIDENCE OF CORNER LOCATION REVIEWED & RATIFIED BY MUSKEGON COUNTY PEER GROUP SEPT. 9, 1993

C. Description of monument for corner and accessories established to perpetuate locating the position of the corner:

SET 4" X 30" CAST IRON MONUMENT WITH COUNTY SURVEY CAP (REPLACED 1/2" IRON ROD)

N 35°W	N 76°E	S 79°E	S 40°E	S 57°W	S 82°W
4.45'	11.75'	37.55'	28.11'	39.30'	46.41'
12" R. PINE	12" R. PINE	8" OAK	8" TW. CHERRY	10" ASPEN	8" MAP.
(FD. NAIL W'LY SIDE)	(FD. NAIL S'LY SIDE)	(SET NAIL N'LY SIDE)	(SET NAIL W'LY SIDE)	(FD. NAIL NE'LY SIDE)	(FD. NAIL S'LY SIDE)

Signed by *Stephen V. Vallier*  
**STEPHEN V. VALLIER**  
Surveyor's Michigan License No. **28428**

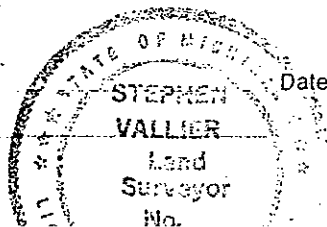

Date *Dec 29, 1993*