

SURVEY & REMONUMENTATION

LIBER **1810** PAGE **566**

STATE OF MICHIGAN
COUNTY OF MUSKEGON
RECEIVED FOR RECORD

LAND CORNER RECORDATION CERTIFICATE
Filing Requirement of Act 74, Mich. P.A. 1970

1994 DEC 29 AM 10:13

For corners in **APR 28 1995**

Carrie Carter
REGISTER OF DEEDS

Muskegon **COMMISSION** Located In: Corner Code #

1. Public Land Survey	T <u>9</u> R <u>15</u>	<u>H-10</u>
	T _____ R _____	_____
	T _____ R _____	_____
	T _____ R _____	_____
2. Property Controlling in Section	S _____ T _____ R _____	_____
	S _____ T _____ R _____	_____
3. Miscellaneous Property in Sec.	S _____ T _____ R _____	_____
	S _____ T _____ R _____	_____

4. Lot No. _____, Recorded Plat _____

5. Private Claims _____

Register of Deeds Stamp & File Number

A1590

	A	B	C	D	E	F	G	H	I	J	K	L	M
2	6		5		4		3		2		1		
3													
4	7		8		9		10		11		12		
5													
6	18		17		16		15		14		13		
7													
8	19		20		21		22		23		24		
9													
10	30		29		28		27		26		25		
11													
12	31		32		33		34		35		36		
13													

I, Stephen V. Vallier, in a field survey on July, 1994, do hereby certify that under requirements of P.A. 74, Michigan P.A. of 1970, the corner points mentioned in lines 1 and 2 above were in conformance with regulations and rules therefore as required in the current manual of survey instructions of the United States Department of the Interior, Bureau of Land Management or by a decree of a Court of Law and/or that the corner points mentioned in lines 3, 4 and 5 above were in conformance with the rules of the Michigan Board of Land Surveyors or by a Decree of a Court of Law; established, re-established, monumented, re-monumented, recovered, found as expressed below:

NOTE: Not more than 4 corners, all in the same town and range, may be recorded on this certificate.

A. Description of original monument and accessories and/or subsequent restoration:

Corner not set by GLO
1980 J. Campbell Liber 1188 Page 210 Set "T" iron on midway distance on East-West 1/4 line.
1990 Liber 1549 Page 566 Found 1/2" capped iron rod at intersection of North-South and East-West 1/4 lines. Reset with 2 3/4" x 30" cast iron monument with County Survey Cap.

B. Description of corner evidence found and/or method applied in restoring or reestablishing corner:

Found 4" cast iron monument with County Survey Cap.
Accepted position of corner. Corner set by acceptable survey method and standards.


POSITION OF SAID
RECORDED CORNER
REVIEWED & RATIFIED
BY MUSKEGON COUNTY
PEER GROUP IN ACCORDANCE
WITH P.A. 845, OF 1990

July 5, 1994

C. Description of monument for corner and accessories established to perpetuate locating the position of the corner:

4" cast iron monument with County Survey Cap.

N 50 deg E	18.70'	North end C.M.P. culvert
N 41 deg E	52.85'	Power Pole with nail
S 26 deg E	51.07'	8" Poplar with nail
S	21.67'	South end C.M.P. culvert
N 79 deg W	82.32'	6" White Cherry with nail

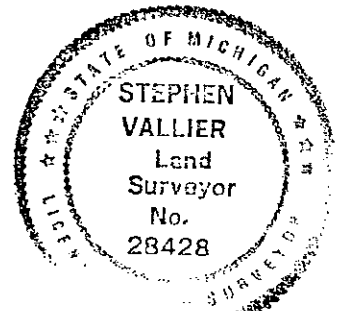

Signed by *Stephen Vallier* Date *Dec 27, 1994*

Surveyor's Michigan License No. 28428