

SURVEY & REMONUMENTATION

LIBER **1810** PAGE **35**

LAND CORNER RECORDATION CERTIFICATE

Filing Requirement of Act 74, Mich. P.A. 1970

APR 28 1995

For corners in

MUSKEGON

(County)

COMMISSION

Located in:

Corner Code #

- | | | | | | |
|------------------------------------|---|----|---|-----|------|
| 1. Public Land Survey | T | 9N | R | 15W | H-12 |
| | T | | R | | |
| | T | | R | | |
| | T | | R | | |
| 2. Property Controlling in Section | S | | T | R | |
| | S | | T | R | |
| 3. Miscellaneous Property in Sec. | S | | T | R | |
| | S | | T | R | |

A 1542

Carroll Carter
REGISTER OF DEEDS

1994 DEC 27 AM 11:41

STATE OF MICHIGAN
COUNTY OF MUSKEGON
REGISTER OF DEEDS

Register of Deeds Stamp & File Number

4. Lot No. _____, Recorded Plat _____
5. Private Claims _____

	A	B	C	D	E	F	G	H	I	J	K	L	A
2	6		5		4		3		2		1		
3													
4	7		8		9		10		11		12		
5													
6	18		17		16		15		14		13		
7													
8	19		20		21		22		23		24		
9													
10	30		29		28		27		26		25		
11													
12	31		32		33		34		35		36		
13													

I, STEPHEN V. VALLIER, in a field survey on _____, 1994, do hereby certify that under requirements of P.A. 74, Michigan P.A. of 1970, the corner points mentioned in lines 1 and 2 above were in conformance with regulations and rules therefore as required in the current manual of survey instructions of the United States Department of the Interior, Bureau of Land Management or by a decree of a Court of Law and/or that the corner points mentioned in lines 3, 4 and 5 above were in conformance with the rules of the Michigan Board of Land Surveyors or by a Decree of a Court of Law; established, re-established, monumented, re-monumented, recovered, found as expressed below:

NOTE: Not more than 4 corners, all in the same town and range, may be recorded on this certificate.

A. Description of original monument and accessories and/or subsequent restoration:

CORNER NOT SET BY GLO 1983 D. SCHIELE, LBR. 1262, PG. 358 REC. SURVEY

1983 D. SCHIELE, LBR. 1262, PG. 353

SET CONCRETE MON.

N 141.0' W. END 12" CMP

NNE 142.4' E. END 12" CMP

S 33.00' IRON

E 5.5' CENTERLINE DIRT DRIVE

B. Description of corner evidence found and/or method applied in restoring or reestablishing corner:

NO EVIDENCE OF CORNER FOUND-DISTURBED CULTIVATED AREA-RESET POSITION OF CORNER BY LBR. 1262, PG. 358-ACCEPTED POSITION OF CORNER BY INTERSECTION OF N-S AND E-W 1/4 LINES

July 5 1994
POSITION OF SAID REQUIRED CORNER REVIEWED & RATIFIED BY MUSKEGON COUNTY PEER GROUP IN ACCORDANCE WITH P.A. 345, OF 1990

C. Description of monument for corner and accessories established to perpetuate locating the position of the corner:

SET 4" X 30" CAST IRON MON. WITH COUNTY SURVEY CAP-NEXT TO 3" X 4" STEEL POST

S 65° E 11.15' 4" TWIN ELM


EAST 828.76' CAPPED IRON ROD

EAST 2649.98' TO E 1/4 CORNER

SOUTH 2651.75' TO S 1/4 CORNER

Signed by

[Signature]

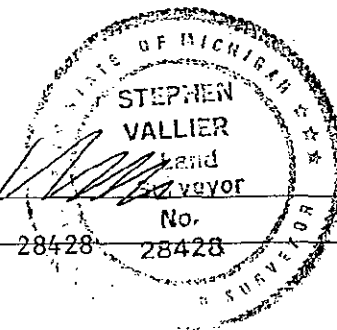

Date

Jan 27, 1994

Surveyor's Michigan License No.

28428 28428