

**SURVEY &
REMONUMENTATION**

LIBER **1810** PAGE **607**

STATE OF MICHIGAN
COUNTY OF MUSKEGON
RECEIVED FOR RECORD

APR 28 1995 **LAND CORNER RECORDATION CERTIFICATE**
Filing Requirement of Act 74, Mich. P.A. 1970

1994 DEC 29 AM 10:16

For corners in

COMMISSION

Muskegon Located In: Corner Code #
(County)

- | | | |
|------------------------------------|-------------------------|------------|
| 1. Public Land Survey | T <u>9</u> R <u>15</u> | <u>I-1</u> |
| | T _____ R _____ | _____ |
| | T _____ R _____ | _____ |
| | T _____ R _____ | _____ |
| 2. Property Controlling in Section | S _____ T _____ R _____ | _____ |
| | S _____ T _____ R _____ | _____ |
| 3. Miscellaneous Property in Sec. | S _____ T _____ R _____ | _____ |
| | S _____ T _____ R _____ | _____ |

Carrie Carter
REGISTER OF DEEDS

A1631

Register of Deeds Stamp & File Number

4. Lot No. _____, Recorded Plat _____
5. Private Claims _____

	A	B	C	D	E	F	G	H	I	J	K	L	M
2	6		5		4		3		2		1		
3													
4	7		8		9		10		11		12		
5													
6	18		17		16		15		14		13		
7													
8	19		20		21		22		23		24		
9													
10	30		29		28		27		26		25		
11													
12	31		32		33		34		35		36		
13													

Stephen V. Vallier a field survey on November, 19 94, do hereby certify that under requirements of P.A. 74, Michigan P.A. of 1970, the corner points mentioned in lines 1 and 2 above were in conformance with regulations and rules therefore as required in the current manual of survey instructions of the United States Department of the Interior, Bureau of Land Management or by a decree of a Court of Law and/or that the corner points mentioned in lines 3, 4 and 5 above were in conformance with the rules of the Michigan Board of Land Surveyors or by a Decree of a Court of Law; established, re-established, monumented, re-monumented, recovered, found as expressed below:

NOTE: Not more than 4 corners, all in the same town and range, may be recorded on this certificate.

A. Description of original monument and accessories and/or subsequent restoration:

- 1837 GLO set corner
1986 C.F. Lewandowski - L.C.R.C. Liber 1345 Page 280 - Found 1" iron pipe in monument box. Reset 2 3/4" x 30" cast iron monument with County Survey Cap in monument box.

B. Description of corner evidence found and/or method applied in restoring or reestablishing corner:

Found 2 3/4" cast iron monument with County survey Cap in monument box. Accepted position of corner due to evidence of Historical usage and consistent documentation.


POSITION OF SAID
RECORDED CORNER
REVIEWED & RATIFIED
BY MUSKEGON COUNTY
PEER GROUP IN ACCORDANCE
WITH P.L.A. 215, OF 1990

Dec 14 1993

C. Description of monument for corner and accessories established to perpetuate locating the position of the corner:

2 3/4" cast iron monument with County Survey Cap in Monument box.

- N 84 deg W 74.65' 12" Oak with nail
E 18.48' Monument
N 82 deg E 78.80' 16" Oak with nail
S 42 deg W 71.61' 12" Oak

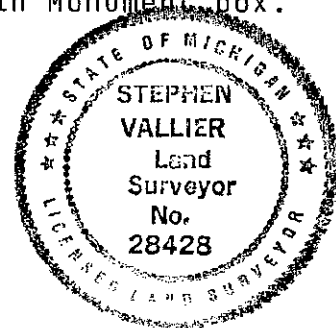

Signed by *Stephen V. Vallier* Date *Dec 27, 1994*
Surveyor's Michigan License No. 28428