

1993  
COMMISSION

LIBER 1744 PAGE 549

STATE OF MICHIGAN  
COUNTY OF MUSKEGON  
RECEIVED FOR RECORD

1993 DEC 29 PM 4:03

LAND CORNER RECORDATION CERTIFICATE  
Filing Requirement of Act 74, Mich. P.A. 1970

*Carrie Carter*  
REGISTER OF DEEDS

For corners in

- Muskegon (County) Located In: Corner Code #1
- Public Land Survey T 9N R 15W I-2  
T R  
T R  
T R
  - Property Controlling S T R  
in Section S T R
  - Miscellaneous S T R  
Property in Sec. S T R
  - Lot No. \_\_\_\_\_, Recorded Plat \_\_\_\_\_
  - Private Claims \_\_\_\_\_

Register of Deeds Stamp & File Number

A	B	C	D	E	F	G	H	I	J	K	L	M
2	6	5	4	3	2							
3												
4	7	8	9	10	11	12						
5												
6	18	17	16	15	14	13						
7												
8	19	20	21	22	23	24						
9												
10	30	29	28	27	26	25						
11												
12	31	32	33	34	35	36						
13												

I, Stephen V. Vallier in a field survey on November 11, 1993, do hereby certify that under requirements of P.A. 74, Michigan P.A. of 1970, the corner points mentioned in lines 1 and 2 above were in conformance with regulations and rules therefore as required in the current manual of survey instructions of the United States Department of the Interior, Bureau of Land Management or by a decree of a Court of Law and/or that the corner points mentioned in lines 3, 4 and 5 above were in conformance with the rules of the Michigan Board of Land Surveyors or by a Decree of a Court of Law; established, re-established, monumented, re-monumented, recovered, found as expressed below:

NOTE: Not more than 4 corners, all in the same town and range, may be recorded on this certificate.

A. Description of original monument and accessories and/or subsequent restoration:  
GLO corner set by J. Mullett, 4-30-1837

Fd. 1/4" iron pipe in Mon. Box  
Westshore Eng. & Survey 9-88  
NE SW SE  
92.90' 81.60' 91.20'  
16" pine 16" oak 18" oak

Hub-M.C.R.C.-1955  
NNW NNE NE  
53.64' 69.9' 193.60'  
6" pop. 5" pop. 6" pop.

B. Description of corner evidence found and/or method applied in restoring or reestablishing corner:

Found 1 1/4" iron pipe in mon. box. Existing corner is confirmed by 1/2 mile meas. to NW cor. and SW cor. by M.C.R.C., Westshore Eng. & Survey. and Moore & Bruggink over a 40-year period.


Historical usage, documentation & evidence of corner location reviewed and ratified by Muskegon County Peer Group June 1, 1993

C. Description of monument for corner and accessories established to perpetuate locating the position of the corner:

Set 2 1/2" x 30" cast iron monument with county survey cap in monument box (replaced found 1 1/4" iron pipe)

S 14 deg. W	S 34 deg W	S 79 deg E	N 50 deg E	N 13 deg W	N 52 deg W	W
196.77'	87.43'	64.41'	75.99'	156.25'	75.97'	50.23'
p. pole	4" oak	6" oak	10" r. pine	p.pole	10" r. pine	cor.
(set nail	(fd. nail	(fd. nail	(fd. nail	(set nail	(fd. nail	fence
w/ tag E'ly	sw'ly side)	nw'ly side)	nw'ly side)	w/tag e'ly	n'ly side)	post
side)				side)		

Signed by: *Stephen V. Vallier*  
Surveyor's Michigan License No. 28428

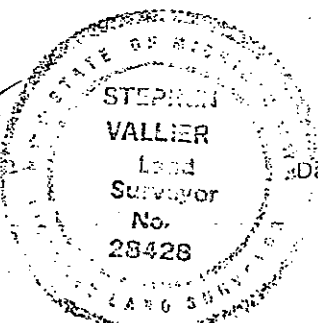

*Dec 28, 1993*