

1993

1993 DEC 29 PM 4: 03

COMMISSION

LAND CORNER RECORDATION CERTIFICATE  
Filing Requirement of Act 74, Mich. P.A. 1970

*Carrie Carter*  
REGISTER OF DEEDS

For corners in  
Muskegon  
(County)

Located In: Corner Code #

- 1. Public Land Survey T 9N R 15W I-3
- 2. Property Controlling in Section S T R
- 3. Miscellaneous Property in Sec. S T R
- 4. Lot No. , Recorded Plat
- 5. Private Claims

Register of Deeds Stamp & File Number

A	B	C	D	E	F	G	H	I	J	K	L	M
6	5	4	3	2	1							
7	8	9	10	11	12							
18	17	16	15	14	13							
19	20	21	22	23	24							
30	29	28	27	26	25							
31	32	33	34	35	36							

I, Stephen V. Vallier in a field survey on November 22, 19 93  
do hereby certify that under requirements of P.A. 74, Michigan P.A. of 1970, the corner points mentioned in lines 1 and 2 above were in conformance with regulations and rules therefore as required in the current manual of survey instructions of the United States Department of the Interior, Bureau of Land Management or by a decree of a Court of Law and/or that the corner points mentioned in lines 3, 4 and 5 above were in conformance with the rules of the Michigan Board of Land Surveyors or by a Decree of a Court of Law; established, re-established, monumented, re-monumented, recovered, found as expressed below:

NOTE: Not more than 4 corners, all in the same town and range, may be recorded on this certificate.

A. Description of original monument and accessories and/or subsequent restoration:  
GLO corner set by J. Mullett, 5-30-1837

S 77 deg E S 68 deg W  
21 links 5 links  
15" hemlock 6" hemlock

Fd. 1 1/2" iron pipe in monument box  
M.C.R.C. July 1976  
(Recorded lbr. 1087, Pg. 697)  
NE SE NW SW  
102.46' 52.22' 72.75' 81.39'  
t. pole g.pole p.pole nail in corner fence post

nail-M.C.R.C.-1955  
NW NW SW  
33.6' 58.50' 45.15'  
sw cor. of p. pole ash  
headwall


B. Description of corner evidence found and/or method applied in restoring or reestablishing corner:

Found 1 1/2" x 24" iron pipe in mon. box  
N 72 deg E  
102.22'  
G. pole

Historical usage, documentation and evidence of corner of location reviewed and ratified by Muskegon County Peer Group, June 1, 1993

C. Description of monument for corner and accessories established to perpetuate locating the position of the corner:

Set 2 3/4" x 20" cast iron monument with county survey cap (replaced 1 1/2" iron pipe recorded in liber 1087, page 697)  
N 35 deg W N 32 deg W S 53 deg W S 45 deg E N 50 deg E N 69 deg E N 72 deg E  
67.62' 113.44' 88.63' 70.96' 122.92' 132.50' 102.22'  
p. pole 6" elm 6" pop. g. pole 6" pop. p. pole g. pole  
(fd. nail (fd. nail (set nail (set nail (fd. nail (fd. nail (fd. nail  
sw'ly side) sw'ly side) nw'ly side) ne'ly side) nw'ly side) n'ly side) nw'ly side)

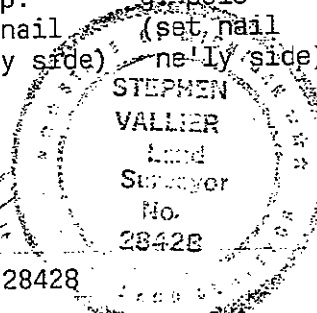

Signed by Stephen V. Vallier  
Surveyor's Michigan License No. 28428

Date Dec 28, 1993