SURVEY 2

LIBER 1744 PAGE 565

STATE OF MICHIGAN
COUNTY OF MUSKEGON
RECEIVED FOR RECORD

1993 DEC 29 PM 4:04

Carrie Carter
REGISTER OF DEEDS

LAND CORNER RECORDATION CERTIFICATE

Filing Requirement of Act 74, Mich. P.A. 1970

For corners in MUSKEGON (County)

	Located In:	Corner Code //
1. Public Land Survey	T 9N R 15W	I-7
	T R	
	T R	
	T R	
2. Property Controlling	S T R	
in Section	S T R	
3. Miscellaneous	S T R	
Property in Sec.	S T R	

1436

Register of Deeds Stamp & File Number

4. Lot No. _____, Recorded Plat _____
5. Private Claims _____

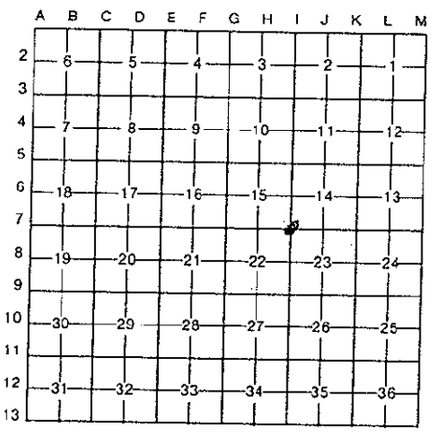

I, STEPHEN V. VALLIER in a field survey on NOVEMBER 23, 19 93 do hereby certify that under requirements of P.A. 74, Michigan P.A. of 1970, the corner points mentioned in lines 1 and 2 above were in conformance with regulations and rules therefore as required in the current manual of survey instructions of the United States Department of the Interior, Bureau of Land Management or by a decree of a Court of Law and/or that the corner points mentioned in lines 3, 4 and 5 above were in conformance with the rules of the Michigan Board of Land Surveyors or by a Decree of a Court of Law; established, re-established, monumented, re-monumented, recovered, found as expressed below:

NOTE: Not more than 4 corners, all in the same town and range, may be recorded on this certificate.

A. Description of original monument and accessories and/or subsequent restoration:

GLO CORNER SET BY J. MULLETT, APR. 29, 1837

S 15°E	N 37°W
15 LINKS	23 LINKS
6" BEECH	12" BEECH

IRON PIPE-MUSKEGON COUNTY ROAD COMMISSION-1955
(NO WITNESSES)

FD. 1½" IRON PIPE-J. CAMPBELL-NOV. 1979
(RECORDED LBR. 1188, PG. 209)

NW	SE
52.35'	66.88'
G. POLE	G. POLE

IRON PIPE IN MONUMENT BOX JULY, 1972
MUSKEGON CO. ROAD COMMISSION
REC. LBR. 1002, PG. 877

WNW	SW	SE
53.88'	70.43'	54.48'
8" PINE	8" PINE	6" PINE

B. Description of corner evidence found and/or method applied in restoring or reestablishing corner:

FOUND ½" IRON PIPE IN MONUMENT BOX

NW
53.82'
12" PINE

HISTORICAL USAGE, DOCUMENTATION & EVIDENCE OF CORNER LOCATION REVIEWED AND RATIFIED BY MUSKEGON COUNTY PEER GROUP, NOVEMBER 2, 1993

C. Description of monument for corner and accessories established to perpetuate locating the position of the corner:

SET 2 3/4" X 20" CAST IRON MONUMENT WITH COUNTY SURVEY CAP IN MONUMENT BOX (REPLACED ½" X 18" IRON PIPE)

S 38°W	N 73°W	N 43°W	N 59°E	N 87°E	S 65°E
89.06'	53.82'	71.63'	69.59'	61.67'	58.36'
12" R. PINE	12" R. PINE	10" R. PINE	10" J. PINE	8" J. PINE	6" J. PINE
(SET NAIL	(SET NAIL	(SET NAIL	(FD. NAIL	(SET NAIL	(SET NAIL
SE'LY SIDE)	NE'LY SIDE)	N'LY SIDE)	N'LY SIDE)	N'LY SIDE)	S'LY SIDE)

STATE OF MICHIGAN
STEPHEN VALLIER
Land Surveyor
No. 28428
LICENSED LAND SURVEYOR

Signed by STEPHEN V. VALLIER Date Dec 28, 1993
Surveyor's Michigan License No. 28428

FORM APPROVED BY MICHIGAN STATE BOARD OF LAND SURVEYORS, JAN. 28, 1971
REVISED MAY 14, 1975
REVISED JAN., 1983