

**SURVEY & REMONUMENTATION**

LIBER **1810** PAGE **11**

APR 28 1995

**LAND CORNER RECORDATION CERTIFICATE**

Filing Requirement of Act 74, Mich. P.A. 1970

For corners in  
**MUSKEGON**

**COMMISSION**

STATE OF MICHIGAN  
 COUNTY OF MUSKEGON  
 RECEIVED FOR RECORD  
 1994 DEC 27 AM 11:40  
 Register of Deeds  
 REGISTER OF DEEDS

*A 1522*

Register of Deeds Stamp & File Number

Corner Code #	Located In:	County
I-8	T <u>9N</u> R <u>15W</u>	MUSKEGON
	T _____ R _____	
	T _____ R _____	
	T _____ R _____	
	S _____ T _____ R _____	
	S _____ T _____ R _____	
	S _____ T _____ R _____	
	S _____ T _____ R _____	

- 4. Lot No. \_\_\_\_\_, Recorded Plat \_\_\_\_\_
- 5. Private Claims \_\_\_\_\_

	A	B	C	D	E	F	G	H	I	J	K	L	M
2	6	5	4	3	2	1							
3													
4	7	8	9	10	11	12							
5													
6	18	17	16	15	14	13							
7													
8	19	20	21	22	23	24							
9													
10	30	29	28	27	26	25							
11													
12	31	32	33	34	35	36							
13													

I, **STEPHEN V. VALLIER**, in a field survey on JULY, 1994, do hereby certify that under requirements of P.A. 74, Michigan P.A. of 1970, the corner points mentioned in lines 1 and 2 above were in conformance with regulations and rules therefore as required in the current manual of survey instructions of the United States Department of the Interior, Bureau of Land Management or by a decree of a Court of Law and/or that the corner points mentioned in lines 3, 4 and 5 above were in conformance with the rules of the Michigan Board of Land Surveyors or by a Decree of a Court of Law; established, re-established, monumented, re-monumented, recovered, found as expressed below:

**NOTE: Not more than 4 corners, all in the same town and range, may be recorded on this certificate.**

**A. Description of original monument and accessories and/or subsequent restoration:**

APRIL 1837, G.L.O SET 1/4 POST	1972 M.C.R.C. FOUND 1 1/2" IRON AND PLACED MON. BOX
S 85° W 4 LINKS 6" HEMLOCK	OVER RECORDED IN LIBER 1002, PG. 875
S 29° W 7 LINKS 6" HEMLOCK	WSW 66.15' 8" PINE
1950'S M.C.R.C.	NW 72.45' 6" PINE
IRON PIPE	ESE 100.5' 6" MAPLE
ENE 101.95' NW COR. HEADWALL	WNW 105.38' 6" PINE
SSE 100.5' 6" MAPLE	1983 M.C.R.C. ROAD CONST. RESET IRON AND
SSE 101.05' 6" MAPLE	MON. BOX, LIBER 1277, PG. 84
	NW 52.38' GUY POLE
	NE 64.97' CONC. PROJ. MARKER

**B. Description of corner evidence found and/or method applied in restoring or reestablishing corner:** (SEE ATTACHMENT)

FOUND 2 3/4" CAST IRON MON. IN MON. BOX

S 44° E 67.57'	P. POLE (FOUND NAIL IN S. SIDE)
S 59° E 51.26'	P. POLE (FOUND NAIL IN S. SIDE)
N 40° W 52.15'	P. POLE (FOUND NAIL IN W. SIDE)
N 41° W 189.47'	12" R. PINE (FOUND IRON IN W. SIDE)
N 65° E 196.07'	14" W. PINE (FOUND NAIL IN S. SIDE)
S 69° E 93.30'	P. POLE (FOUND NAIL IN N. SIDE)

*June 7 1994*


POSITION OF SAID  
 RECORDED CORNER  
 REVIEWED & RATIFIED  
 BY MUSKEGON COUNTY  
 PEER GROUP IN ACCORDANCE  
 WITH P.A. 345 OF 1990

**C. Description of monument for corner and accessories established to perpetuate locating the position of the corner:**

FOUND 2 3/4" CAST IRON MON. IN MON. BOX

S 44° E 67.57'	P. POLE (FOUND NAIL IN S. SIDE)
S 59° E 51.26"	P. POLE (FOUND NAIL IN S. SIDE)
N 40° W 52.15'	P. POLE (FOUND NAIL IN W. SIDE)
N 41° W 189.47'	12" R. PINE (FOUND NAIL IN W. SIDE)
N 65° E 196.07'	14" W. PINE (FOUND NAIL IN S. SIDE)
N 69° E 93.30'	P. POLE (FOUND NAIL IN N. SIDE)

Signed by *Stephen Vallier*  
 Surveyor's Michigan License No. 28428

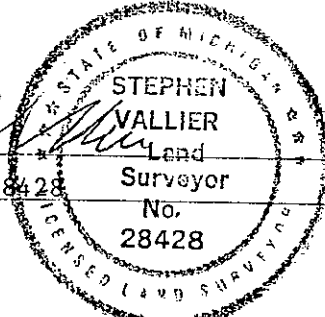

Date *Dec 24, 1994*

ATTACHMENT TO SECTION "A"  
LAND CORNER RECORDATION CERTIFICATE

MUSKEGON COUNTY, T9N, R15W CORNER I-8

ESE 93.25' GUY POLE  
SW 51.16' T. POLE  
1978 C.P. ENGLERT RECORDED SURVEY LIBER 1136, PAGE 971  
FOUND 1" PIPE IN MONUMENT BOX