

SURVEY & REMONUMENTATION

LIBER **1810** PAGE **13**

STATE OF MICHIGAN
COUNTY OF MUSKEGON
RECEIVED FOR RECORD

APR 28 1995

LAND CORNER RECORDATION CERTIFICATE

1994 DEC 27 AM 11:40

COMMISSION

Filing Requirement of Act 74, Mich. P.A. 1970

For corners in

MUSKEGON

(County)

Located In:

Corner Code ##

- | | | |
|------------------------------------|--------------------------|------------|
| 1. Public Land Survey | T <u>9N</u> R <u>15W</u> | <u>I-9</u> |
| | T _____ R _____ | _____ |
| | T _____ R _____ | _____ |
| | T _____ R _____ | _____ |
| 2. Property Controlling in Section | S _____ T _____ R _____ | _____ |
| | S _____ T _____ R _____ | _____ |
| 3. Miscellaneous Property in Sec. | S _____ T _____ R _____ | _____ |
| | S _____ T _____ R _____ | _____ |

Carris Carter
REGISTER OF DEEDS

A1523

Register of Deeds Stamp & File Number

4. Lot No. _____, Recorded Plat _____
5. Private Claims _____

I, STEPHEN V. VALJIER, in a field survey on JULY, 19 94, do hereby certify that under requirements of P.A. 74, Michigan P.A. of 1970, the corner points mentioned in lines 1 and 2 above were in conformance with regulations and rules therefore as required in the current manual of survey instructions of the United States Department of the Interior, Bureau of Land Management or by a decree of a Court of Law and/or that the corner points mentioned in lines 3, 4 and 5 above were in conformance with the rules of the Michigan Board of Land Surveyors or by a Decree of a Court of Law; established, re-established, monumented, re-monumented, recovered, found as expressed below:

| | A | B | C | D | E | F | G | H | I | J | K | L | M |
|----|----|----|----|----|----|----|---|---|---|---|---|---|---|
| 2 | 6 | 5 | 4 | 3 | 2 | 1 | | | | | | | |
| 3 | | | | | | | | | | | | | |
| 4 | 7 | 8 | 9 | 10 | 11 | 12 | | | | | | | |
| 5 | | | | | | | | | | | | | |
| 6 | 13 | 17 | 16 | 15 | 14 | 13 | | | | | | | |
| 7 | | | | | | | | | | | | | |
| 8 | 19 | 20 | 21 | 22 | 23 | 24 | | | | | | | |
| 9 | | | | | | | | | | | | | |
| 10 | 30 | 29 | 28 | 27 | 26 | 25 | | | | | | | |
| 11 | | | | | | | | | | | | | |
| 12 | 31 | 32 | 33 | 34 | 35 | 36 | | | | | | | |
| 13 | | | | | | | | | | | | | |

NOTE: Not more than 4 corners, all in the same town and range, may be recorded on this certificate.

A. Description of original monument and accessories and/or subsequent restoration:

- | | |
|-----------------------------------|---|
| APRIL 1837 GLO SET SECTION CORNER | 1972 M.C.R.C. |
| S 8° E 15 LINKS 10" BEECH | FOUND 1" IRON PLACED MON. BOX OVER IRON |
| N 24° W 24 LINKS 10" BEECH | SW 74.11' T. POLE |
| | ESE 53.85' 12" PINE |
| 1950'S M.C.R.C. IRON | SE 57.70' T. POLE |
| NW 51.75' 4" POPLAR | SE 39.94' 12" PINE |
| NW 104.23' 4" POPLAR | 1978 C.P. ENGLERT |
| SW 48.68' IRON | 1" IRON PIPE IN MON. BOX, LBR. 1136, PG. 87 |
| SW 58.90' 4" CATALPA | NE 65.00' PROJEC |
| | SE 66.86' P. POLE |

SEE ATTACHMENT

B. Description of corner evidence found and/or method applied in restoring or reestablishing corner:

- FOUND CAST IRON MONUMENT AS REC. IN LBR. 1549, PG. 564
DEC. 1990 WESTSHORE ENG.
FOUND 1" IRON X 24" IN MON. BOX - REPLACED IRON WITH 2 3/4" X 30" CAST IRON MONUMENT WITH COUNTY SURVEY CAP, LBR. 1549, PG. 564
- | | |
|-----------------|--------------------------|
| S 85° E 39.71' | NAIL N. SIDE 24" R. PINE |
| S 33° E 57.91' | NAIL N. SIDE T. POLE |
| S 64° W 74.11' | NAIL N. SIDE P. POLE |
| N 68° W 97.94' | NAIL S. SIDE 8" CHERRY |
| N 22° E 169.40' | NAIL W. SIDE 12" W. PINE |
- POSITION IS CONSISTENT WITH WITNESSES AND SECTIONAL MEASUREMENTS FOR 45 YEAR SPAN-ACCEPTED CORNER AS HISTORICAL AND DOCUMENTED LOCATION

June 7, 1994
SW


IRON MONUMENT WITH POSITION OF SAID RECORDED CORNER REVIEWED & RATIFIED BY MUSKEGON COUNTY PEER GROUP IN ACCORDANCE WITH P.A. 345, OF 1990

C. Description of monument for corner and accessories established to perpetuate locating the position of the corner:

- CAST IRON COUNTY SURVEYOR MONUMENT WITH COUNTY SURVEY CAP
DECEMBER 1990 WESTSHORE ENGINEERING
FOUND 1" X 24" IRON IN MON. BOX-REPLACED IRON WITH 2 3/4" X 30" CAST IRON MONUMENT WITH COUNTY SURVEY CAP, LBR. 1549, PG. 564
- | | |
|-----------------|--------------------------|
| S 85° E 39.71' | NAIL N. SIDE 24" R. PINE |
| S 33° E 57.91' | NAIL N. SIDE T. POLE |
| S 64° W 74.11' | NAIL N. SIDE P. POLE |
| N 68° W 97.94' | NAIL S. SIDE 8" CHERRY |
| N 22° E 169.40' | NAIL W. SIDE 12" W. PINE |

Signed by _____

Stephen Valjier

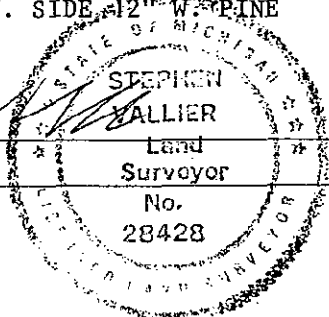

Date _____

Dec 27, 1994

Surveyor's Michigan License No. 28428

9.0

MUSKEGON COUNTY, T9N, R15W CORNER I-9

SECTION A:

1978 C.P. ENGLERT, LBR. 1136, PG. 87
(CONTINUED)

| | | |
|----|--------|---------|
| SW | 31.85' | T. POLE |
| NW | 51.81' | G. POLE |

DECEMBER 1990, WESTSHORE ENGINEERING & SURVEYING, INC.
FOUND 1" IRON X 24" IN MON. BOX-REPLACED IRON WITH 2 3/4" X 30" CAST IRON MONUMENT
WITH COUNTY SURVEY CAP, LBR. 1549, PG. 564

| | | |
|---------|---------|--------------------------|
| S 85° E | 39.71' | NAIL N. SIDE 24" R. PINE |
| S 33° E | 57.91' | NAIL N. SIDE T. POLE |
| S 64° W | 74.11' | NAIL N. SIDE P. POLE |
| N 68° W | 97.94' | NAIL S. SIDE 8" CHERRY |
| N 22° E | 169.40' | NAIL W. SIDE 12" W. PINE |