

LAND CORNER RECORDATION CERTIFICATE
Filing Requirement of Act 74, Mich. P.A. 1970

1994 DEC 29 AM 10:17

For corners in

Muskegon

(County)

Located In:

Corner Code #

Carrie Carter
REGISTER OF DEEDS

- 1. Public Land Survey T 9 R 15 I-10
T _____ R _____
T _____ R _____ SURVEY &
T _____ R _____ REMONUMENTATION
- 2. Property Controlling S _____ T _____ R _____
in Section S _____ T _____ R _____ NOV 28 2000
- 3. Miscellaneous S _____ T _____ R _____
Property in Sec. S _____ T _____ R _____
- 4. Lot No. _____, Recorded Plat _____
- 5. Private Claims _____ SECTION

Register of Deeds Stamp & File Number

A1638

I, Stephen V. Vallier a field surveyor on November, 1994, do hereby certify that under requirements of P.A. 74, Michigan P.A. of 1970, the corner points mentioned in lines 1 and 2 above were in conformance with regulations and rules therefore as required in the current manual of survey instructions of the United States Department of the Interior, Bureau of Land Management or by a decree of a Court of Law and/or that the corner points mentioned in lines 3, 4 and 5 above were in conformance with the rules of the Michigan Board of Land Surveyors or by a Decree of a Court of Law; established, re-established, monumented, re-monumented, recovered, found as expressed below:

NOTE: Not more than 4 corners, all in the same town and range, may be recorded on this certificate.

	A	B	C	D	E	F	G	H	I	J	K	L	M
2	6	5	4	3	2								
3													
4	7	8	9	10	11	12							
5													
6	18	17	16	15	14	13							
7													
8	19	20	21	22	23	24							
9													
10	30	29	28	27	26	25							
11													
12	31	32	33	34	35	36							
13													

A. Description of original monument and accessories and/or subsequent restoration:

- 1837 GLO set corner
- 1950's M.C.R.C. Tie Map - Iron pipe
- 1976 M.C.R.C. - L.C.R.C. Liber 1002 Page 891 - Found pipe - set 1/2" re-rod in monument box.
- 1990 Westshore Engineering - L.C.R.C. Liber 1549 Page 564 - Found 1/2" re-rod in monument box. Reset with 2 3/4" cast iron monument with County Survey Cap in monument box.

B. Description of corner evidence found and/or method applied in restoring or reestablishing corner:


Found 2 3/4" cast iron monument in monument box with County Survey Cap. Accepted position of corner due to Historical usage and consistent documentation.

POSITION OF SAID
RECORDED CORNER
REVIEWED & RATIFIED
BY MUSKEGON COUNTY
PEER GROUP IN ACCORDANCE
WITH P.A. 315, OF 1990
June 7, 1994

C. Description of monument for corner and accessories established to perpetuate locating the position of the corner:

2 3/4" cast iron monument in monument box with County Survey cap in monument box.

- N 31 deg E 55.03' Light Pole with nail
- N 44 deg W 80.20' Power Pole with nail
- N 75 deg E 52.15' Telephone Pole with Nail
- NW 50.25' Northwest corner concrete headwall

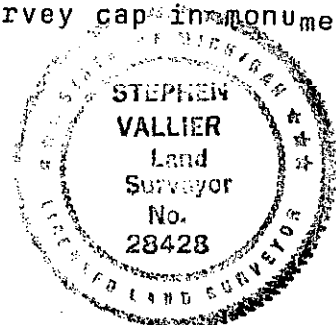

Signed by *Stephen Vallier*
Surveyor's Michigan License No. 28428

Date Jun 27, 1994