

1993

LIBR 1744 FILE 558

STATE OF MICHIGAN  
COUNTY OF MUSKEGON  
RECEIVED FOR RECORD

1993 DEC 29 PM 4:03

COUNTY

LAND CORNER RECORDATION CERTIFICATE  
Filing Requirement of Act 74, Mich. P.A. 1970

*Carrie Carter*  
REGISTER OF DEEDS

For corners in

MUSKEGON

County

Located In:

Corner Code: #

- 1. Public Land Survey                    T 9N R 15W                    J-2  
    T                    R  
    T                    R  
    T                    R
- 2. Property Controlling                S                    T                    R  
   in Section                                S                    T                    R
- 3. Miscellaneous                        S                    T                    R  
   Property in Sec.                        S                    T                    R

411399

Register of Deeds Stamp & File Number

- 4. Lot No. \_\_\_\_\_, Recorded Plat \_\_\_\_\_
- 5. Private Claims \_\_\_\_\_

|    | A  | B  | C  | D  | E  | F  | G | H | I | J | K | L | M |
|----|----|----|----|----|----|----|---|---|---|---|---|---|---|
| 2  | 6  | 5  | 4  | 3  |    |    |   |   |   |   |   |   |   |
| 3  |    |    |    |    |    |    |   |   |   |   |   |   |   |
| 4  | 7  | 8  | 9  | 10 | 11 | 12 |   |   |   |   |   |   |   |
| 5  |    |    |    |    |    |    |   |   |   |   |   |   |   |
| 6  | 18 | 17 | 16 | 15 | 14 | 13 |   |   |   |   |   |   |   |
| 7  |    |    |    |    |    |    |   |   |   |   |   |   |   |
| 8  | 19 | 20 | 21 | 22 | 23 | 24 |   |   |   |   |   |   |   |
| 9  |    |    |    |    |    |    |   |   |   |   |   |   |   |
| 10 | 30 | 29 | 28 | 27 | 26 | 25 |   |   |   |   |   |   |   |
| 11 |    |    |    |    |    |    |   |   |   |   |   |   |   |
| 12 | 31 | 32 | 33 | 34 | 35 | 36 |   |   |   |   |   |   |   |
| 13 |    |    |    |    |    |    |   |   |   |   |   |   |   |

I, Stephen V. Vallier, on a field survey on December 1, 1993, do hereby certify that under requirements of P.A. 74, Michigan P.A. of 1970, the corner points mentioned in lines 1 and 2 above were in conformance with regulations and rules therefore as required in the current manual of survey instructions of the United States Department of the Interior, Bureau of Land Management or by a decree of a Court of Law and/or that the corner points mentioned in lines 3, 4 and 5 above were in conformance with the rules of the Michigan Board of Land Surveyors or by a Decree of a Court of Law; established, re-established, monumented, re-monumented, recovered, found, as expressed below:

NOTE: Not more than 4 corners, all in the same town and range, may be recorded on this certificate.

A. Description of original monument and accessories and/or subsequent restoration:  
Corner not set by GLO

No evidence or record of corner ever being set

B. Description of corner evidence found and/or method applied in restoring or reestablishing corner:  
Found 1/2" x 18" iron rod 2.2 feet south of and 3 feet east of computed center of section by intersection of 1/4 lines.  
Accepted found 1/2" iron rod as center of section; occupation lies 3.5' north to E-W fence and 3 feet east to fence line to north.

Historical usage, documentation and evidence of corner location reviewed and ratified by Muskegon County Peer Group, Nov. 2, 1993

C. Description of monument for corner and accessories established to perpetuate locating the position of the corner:


|   |              |                      |                   |                   |                       |
|---|--------------|----------------------|-------------------|-------------------|-----------------------|
| Set 4" x 30" cast iron monument with County Survey cap (replaced found 1/2" x 18" iron rod) |              |                      |                   |                   |                       |
| S 40 deg. E   | N 42 deg. E  | S 5 deg. W           | S 9 deg. E        | N 15 deg W        | N 43 deg W            |
| 7.81'   | 4.61'        | 94.93'               | 33.02'            | 26.94'            | 63.37'                |
| 10" tw. map.  | center fence | 16" w. pine          | 12" pop.          | 16" tri. map.     | 8" pop.               |
| (set nail w'ly side)  | post at top  | (set nail w'ly side) | (set nail W side) | (set nail E side) | (set nail sw'ly side) |

Signed by

*Stephen V. Vallier*  
Stephen V. Vallier

Surveyor's Michigan License No.

28428

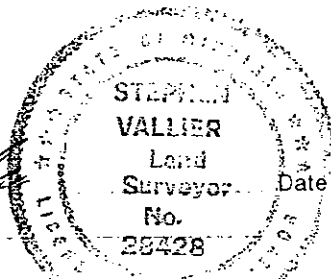

Date

*Dec 28, 1993*