

**SURVEY &
REMONUMENTATION**

LIBER **1810** PAGE **23**

APR 28 1995

COMMISSION LAND CORNER RECORDATION CERTIFICATE
Filing Requirement of Act 74, Mich. P.A. 1970

For corners in

<u>MUSKEGON</u> <small>(County)</small>	Located In:	Corner Code #
1. Public Land Survey	T <u>9</u> R <u>15</u>	<u>J-9</u>
	T _____ R _____	_____
	T _____ R _____	_____
2. Property Controlling in Section	S _____ T _____ R _____	_____
	S _____ T _____ R _____	_____
3. Miscellaneous Property in Sec.	S _____ T _____ R _____	_____
	S _____ T _____ R _____	_____

A1530

STATE OF MICHIGAN
 COUNTY OF MUSKEGON
 REGISTER OF DEEDS
 1994 DEC 27 AM 11:40
 Register of Deeds Stamp & File Number

4. Lot No. _____, Recorded Plat _____
 5. Private Claims _____

	A	B	C	D	E	F	G	H	I	J	K	L	M
2	6		5		4		3		2		1		
3													
4	7		8		9		10		11		12		
5													
6	18		17		16		15		14		13		
7													
8	19		20		21		22		23		24		
9													
10	30		29		28		27		26		25		
11													
12	31		32		33		34		35		36		
13													

I, STEPHEN V. VALLIER, in a field survey on DECEMBER, 19 91, do hereby certify that under requirements of P.A. 74, Michigan P.A. of 1970, the corner points mentioned in lines 1 and 2 above were in conformance with regulations and rules therefore as required in the current manual of survey instructions of the United States Department of the Interior, Bureau of Land Management or by a decree of a Court of Law and/or that the corner points mentioned in lines 3, 4 and 5 above were in conformance with the rules of the Michigan Board of Land Surveyors or by a Decree of a Court of Law; established, re-established, monumented, re-monumented, recovered, found as expressed below:

NOTE: Not more than 4 corners, all in the same town and range, may be recorded on this certificate.

- A. Description of original monument and accessories and/or subsequent restoration:
- | | |
|----------------------------------|--------------------------------|
| G.L.O. APRIL 1837 SET 1/4 POST | C.P. ENGLERT 1990 |
| N 77° E 19 LINKS 12" MAPLE | FOUND 1/2" REBAR WIRE TO NORTH |
| S 74° E 17" 12" YELLOW BIRCH | RECORDED LIBER 1566 PG. 66 |
| MUSKEGON COUNTY ROAD COMM. 1980± | W 36.81' 6" MAPLE |
| IRON ON FENCE | NW 33.30 12" MAPLE |
| | N 23.70' 5" ASH |
| | E 17.22' 12" ASPEN |


- B. Description of corner evidence found and/or method applied in restoring or reestablishing corner:
- FOUND 1/2" X 18" IRON ROD
 N36°W 33.30' 12" MAPLE (FOUND NAIL N. SIDE)
 N 0°E 23.72' 6" ELM (FOUND NAIL E. SIDE)
 S78°E 17.22' 12" ASPEN (FOUND NAIL N. SIDE)

June 7, 1994

POSITION OF SAID
 RECORDED CORNER
 REVIEWED & RATIFIED
 BY MUSKEGON COUNTY
 DEER GROUP IN ACCORDANCE
 WITH P.A. 345, OF 1990

- C. Description of monument for corner and accessories established to perpetuate locating the position of the corner:
- REPLACED 1/2" X 18" ON ROD WITH 4" CAST IRON MONUMENT WITH COUNTY SURVEYOR CAP.
- N36W 33.30' 12" MAPLE (FOUND NAIL N. SIDE)
 N0°E 23.72' 6" ELM (FOUND NAIL E. SIDE)
 S78°E 17.22' 12" ASPEN (FOUND NAIL N. SIDE)
- S12°E 19.40' 6" ELM (SET NAIL W. SIDE)
 S33°W 27.00' 6" ELM (SET NAIL S. SIDE)

Signed by *Stephen V. Vallier*
 Surveyor's Michigan License No. 28428

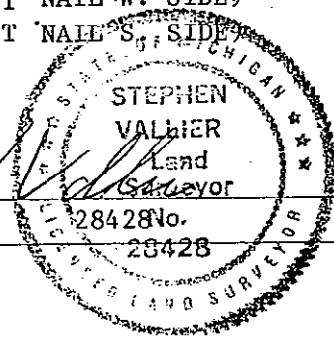

Date *Dec 24, 1994*