

APR 28 1995

LAND CORNER RECORDATION CERTIFICATE
Filing Requirement of Act 74, Mich. P.A. 1970

COMMISSION

For corners in
MUSKEGON
(County)

Located In:

Corner Code #

1. Public Land Survey

T 9N R 15W

J-11

2. Property Controlling in Section

S T R

3. Miscellaneous Property in Sec.

S T R

4. Lot No. _____, Recorded Plat _____

5. Private Claims _____

A 1532

James Carter
REGISTER OF DEEDS

1995 DEC 27 AM 11:41

STATE OF MICHIGAN
COUNTY OF MUSKEGON
REGISTER OF DEEDS

Register of Deeds Stamp & File Number

	A	B	C	D	E	F	G	H	I	J	K	L	M
2	6	5	4	3	2	1							
3													
4	7	8	9	10	11	12							
5													
6	18	17	16	15	14	13							
7													
8	19	20	21	22	23	24							
9													
10	30	29	28	27	26	25							
11													
12	31	32	33	34	35	36							
13													

I, STEPHEN V. VALLIER, in a field survey on NOVEMBER, 19 94, do hereby certify that under requirements of P.A. 74, Michigan P.A. of 1970, the corner points mentioned in lines 1 and 2 above were in conformance with regulations and rules therefore as required in the current manual of survey instructions of the United States Department of the Interior, Bureau of Land Management or by a decree of a Court of Law and/or that the corner points mentioned in lines 3, 4 and 5 above were in conformance with the rules of the Michigan Board of Land Surveyors or by a Decree of a Court of Law; established, re-established, monumented, re-monumented, recovered, found as expressed below:

NOTE: Not more than 4 corners, all in the same town and range, may be recorded on this certificate.

A. Description of original monument and accessories and/or subsequent restoration:

APRIL 1837 G.L.O. SET 1/4 POST
6" W. ASH AT 1/4 SECTION CORNER

1929 M.C.R.C. FOUND WOOD HUB AT FENCE
LINE
DISTANCE 2603.72' TO SW CORNER

C.P. ENGLERT 1980'S
FOUND 1" IRON

S 32.57' FENCE CORNER
SE 31.25' FENCE POST
N 40.76' FENCE POST

B. Description of corner evidence found and/or method applied in restoring or reestablishing corner:


FOUND 1/2" X 18" CAPPED IRON ROD (NON-LEGIBLE)
VERIFIED DISTANCE OF 2603.34' TO SW CORNER
FOUND IRON ON BRUSH ROW TO NORTH AND OLD FENCE TO SOUTH

June 7, 1994
POSITION OF SAID
RECORDED CORNER
REVIEWED & RATIFIED
BY MUSKEGON COUNTY
PEER GROUP IN ACCORDANCE
WITH P.A. 345, OF 1970

C. Description of monument for corner and accessories established to perpetuate locating the position of the corner:

REPLACED FOUND 1/2" X 18" IRON ROD WITH CAST IRON MONUMENT WITH COUNTY SURVEYOR CAP-2 3/4" X 30'
N 25° E 155.42' LIGHT POLE (SET P.K. NAIL WEST SIDE)
S 0° E 30.00' P. POLE (FOUND NAIL EAST SIDE)
N 45° W 44.67' GUY POLE (SET NAIL W. SIDE)
S 23° E 301.53' P. POLE (SET NAIL N. SIDE)

Signed by *[Signature]*

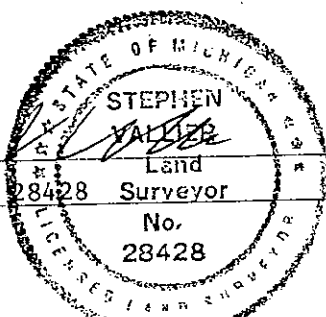

Date *Dec 24, 1994*

Surveyor's Michigan License No. 28428