

**SURVEY &  
REMONUMENTATION**

LIBER **1810** PAGE **26**

APR 28 1995

**LAND CORNER RECORDATION CERTIFICATE**

Filing Requirement of Act 74, Mich. P.A. 1970

**COMMISSION**

For corners in

MUSKEGON

(County)

Located In:

Corner Code #

- |                                    |   |           |   |            |             |
|------------------------------------|---|-----------|---|------------|-------------|
| 1. Public Land Survey              | T | <u>9N</u> | R | <u>15W</u> | <u>J-13</u> |
|                                    | T |           | R |            |             |
|                                    | T |           | R |            |             |
|                                    | T |           | R |            |             |
| 2. Property Controlling in Section | S |           | R |            |             |
|                                    | S |           | R |            |             |
| 3. Miscellaneous Property in Sec.  | S |           | R |            |             |
|                                    | S |           | R |            |             |

*A 1533*

*Collier Carter*  
REGISTER OF DEEDS

STATE OF MICHIGAN  
COUNTY OF MUSKEGON  
RECEIVED AND RECORDED  
1994 DEC 27 AM 11:41

Register of Deeds Stamp & File Number

4. Lot No. \_\_\_\_\_, Recorded Plat \_\_\_\_\_  
5. Private Claims \_\_\_\_\_

	A	B	C	D	E	F	G	H	I	J	K	L	M
2	6	5	4	3	2	1							
3													
4	7	8	9	10	11	12							
5													
6	16	17	18	15	14	13							
7													
8	19	20	21	22	23	24							
9													
10	30	29	28	27	26	25							
11													
12	31	32	33	34	35	36							
13													

I, STEPHEN V. VALLIER, in a field survey on JULY, 19 94, do hereby certify that under requirements of P.A. 74, Michigan P.A. of 1970, the corner points mentioned in lines 1 and 2 above were in conformance with regulations and rules therefore as required in the current manual of survey instructions of the United States Department of the Interior, Bureau of Land Management or by a decree of a Court of Law and/or that the corner points mentioned in lines 3, 4 and 5 above were in conformance with the rules of the Michigan Board of Land Surveyors or by a Decree of a Court of Law; established, re-established, monumented, re-monumented, recovered, found as expressed below:

**NOTE: Not more than 4 corners, all in the same town and range, may be recorded on this certificate.**

A. Description of original monument and accessories and/or subsequent restoration:

APRIL 1837 G.L.O. SET QUARTER POST  
N 82° E 31 LINKS 6" HEMLOCK  
N 30° W 40 LINKS 7" HEMLOCK

1950'S MUSKEGON COUNTY ROAD COMMISSION  
3/4" IRON  
SE 33.70' 6" PINE  
S 28.12" FENCE POST  
NNW 29.42' 40" MAPLE

B. Description of corner evidence found and/or method applied in restoring or reestablishing corner:


FOUND, CAST IRON MONUMENT WITH COUNTY SURVEYOR CAP (4") IN MON. BOX  
ACCEPTED POSITION OF CORNER DUE TO HISTORICAL USAGE AND DOCUMENTATION

*June 7, 1994*  
POSITION OF SAID RECORDED CORNER REVIEWED & RATIFIED BY MUSKEGON COUNTY PEER GROUP IN ACCORDANCE WITH P.A. 345, OF 1990

C. Description of monument for corner and accessories established to perpetuate locating the position of the corner:

4" CAST IRON MON. WITH COUNTY SURVEY CAP ON MON. BOX  
N 27° W 31.29' NAIL IN N. SIDE 20-40" TWIN MAPLE  
S 51° E 57.00' NAIL IN N. SIDE 14" R. PINE  
S 20° W 41.38' NAIL IN E. SIDE 6" POPLAR  
S 31° E 57.11' NAIL IN S. SIDE 12" R. PINE  
N 45° E 53.93' NAIL IN S. SIDE 10" PINE

Signed by *Stephen Vallier*

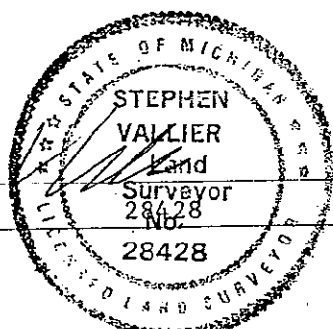

Date Dec 24, 1994

Surveyor's Michigan License No. \_\_\_\_\_