

SURVEY & REMONUMENTATION

LIBER **1810** PAGE **603**

STATE OF MICHIGAN
COUNTY OF MUSKEGON
RECEIVED FOR RECORD

APR 28 1995

LAND CORNER RECORDATION CERTIFICATE
Filing Requirement of Act 74, Mich. P.A. 1970

1994 DEC 29 AM 10:16

COMMISSION

Carrie Carter
REGISTER OF DEEDS

For corners in

<u>Muskegon</u> <small>(County)</small>	Located In:	Corner Code #
1. Public Land Survey	T <u>9</u> R <u>15</u>	<u>K-3</u>
	T _____ R _____	_____
	T _____ R _____	_____
	T _____ R _____	_____
2. Property Controlling in Section	S _____ T _____ R _____	_____
	S _____ T _____ R _____	_____
3. Miscellaneous Property in Sec.	S _____ T _____ R _____	_____
	S _____ T _____ R _____	_____
4. Lot No. _____, Recorded Plat _____		
5. Private Claims _____		

A1627

Register of Deeds Stamp & File Number

I, Stephen V. Vallier, in a field survey on November, 1994, do hereby certify that under requirements of P.A. 74, Michigan P.A. of 1970, the corner points mentioned in lines 1 and 2 above were in conformance with regulations and rules therefore as required in the current manual of survey instructions of the United States Department of the Interior, Bureau of Land Management or by a decree of a Court of Law and/or that the corner points mentioned in lines 3, 4 and 5 above were in conformance with the rules of the Michigan Board of Land Surveyors or by a Decree of a Court of Law; established, re-established, monumented, re-monumented, recovered, found as expressed below:

A	B	C	D	E	F	G	H	I	J	K	L	M
2	6	5	4	3	2	1						
3										●		
4	7	8	9	10	11	12						
5												
6	18	17	16	15	14	13						
7												
8	19	20	21	22	23	24						
9												
10	30	29	28	27	26	25						
11												
12	31	32	33	34	35	36						
13												

NOTE: Not more than 4 corners, all in the same town and range, may be recorded on this certificate.

A. Description of original monument and accessories and/or subsequent restoration:

- 1837 GLO set corner
- 1972 C.P. Englert - L.C.R.C. Liber 993 Page 552 - Found P.K. Nail
- 1976 M.C.R.C. - L.C.R.C. Liber 1087 Page 679 - Found P.K. Reset monument box with 1/2" re-rod
- 1985 C.F. Lewandowski - L.C.R.C. Liber 1320 Page 471 - Found 1/2" re-rod in monument box. Reset 2 3/4" x 30" cast iron monument in monument box with County Survey Cap.

B. Description of corner evidence found and/or method applied in restoring or reestablishing corner:

Found 2 3/4" cast iron monument with County Survey Cap in Monument box. Accepted position of corner due to evidence of Historical usage and consistent documentation.


POSITION OF SAID
RECORDED CORNER
REVIEWED & RATIFIED
BY MUSKEGON COUNTY
PEER GROUP IN ACCORDANCE
WITH P.A. 345, OF 1990

Jul 14, 1993

C. Description of monument for corner and accessories established to perpetuate locating the position of the corner:

2 3/4" cast iron monument with County Survey Cap in monument box.

- N 55 deg E 75.92' Power Pole with nail
- S 50 deg E 55.53' Telephone Pole with nail
- S 40 deg W 43.77' Telephone Pole with nail
- N 55 deg W 87.85' Southwest corner brick building

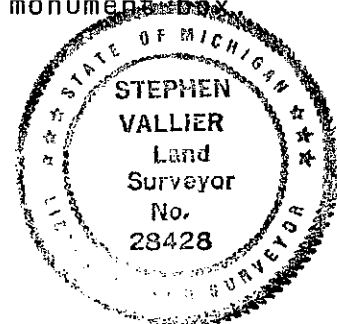

Signed by *Stephen Vallier*

Date *Jul 27, 1994*

Surveyor's Michigan License No. 28428