

**SURVEY &
REMONUMENTATION**

APR 28 1995

LIBER 1810 PAGE 534

COMMISSION LAND CORNER RECORDATION CERTIFICATE
Filing Requirement of Act 74, Mich. P.A. 1970

For corners in

MUSKEGON
(County)

Located In:

Corner Code =#

- | | | |
|------------------------------------|-------------------------|------------|
| 1. Public Land Survey | T <u>9</u> R <u>15</u> | <u>K-4</u> |
| | T _____ R _____ | _____ |
| | T _____ R _____ | _____ |
| | T _____ R _____ | _____ |
| 2. Property Controlling in Section | S _____ T _____ R _____ | _____ |
| | S _____ T _____ R _____ | _____ |
| 3. Miscellaneous Property in Sec. | S _____ T _____ R _____ | _____ |
| | S _____ T _____ R _____ | _____ |

A1558

STATE OF MICHIGAN
 COUNTY OF MUSKEGON
 REGISTER OF DEEDS
 1994 DEC 29 AM 10:09
Robin Carter

Register of Deeds Stamp & File Number

4. Lot No. _____, Recorded Plat _____
5. Private Claims _____

A	B	C	D	E	F	G	H	I	J	K	L	M
2	6	5	4	3	2	1						
3												
4	7	8	9	10	11	12						
5												
6	18	17	16	15	14	13						
7												
8	19	20	21	22	23	24						
9												
10	30	29	28	27	26	25						
11												
12	31	32	33	34	35	36						
13												

I, STEPHEN V. VALLIER in a field survey on JULY, 1994, do hereby certify that under requirements of P.A. 74, Michigan P.A. of 1970, the corner points mentioned in lines 1 and 2 above were in conformance with regulations and rules therefore as required in the current manual of survey instructions of the United States Department of the Interior, Bureau of Land Management or by a decree of a Court of Law and/or that the corner points mentioned in lines 3, 4 and 5 above were in conformance with the rules of the Michigan Board of Land Surveyors or by a Decree of a Court of Law; established, re-established, monumented, re-monumented, recovered, found as expressed below:

NOTE: Not more than 4 corners, all in the same town and range, may be recorded on this certificate.

A. Description of original monument and accessories and/or subsequent restoration:

- 1837 GLO SET 1/4 CORNER
- 1870 CORNER REFLECTS ON PLAT OF CATLIN & MUNGERS, E-W 1/4 LINE SHOWN ALONG RAIL ROAD
- 1900 GTWRR MAP SHOWS CORNER ON CENTERLINE OF RAIL ROAD
- 1950's MUSKEGON COUNTY ROAD COMMISSION TIE MAP RAIL ROAD SPIKE
- 1985 C.F. LEWANDOWSKI FOUND 1/2 IRON PIPE ON 1 1/2" IRON APPROXIMATELY 5' N.E CENTER LINE RAIL ROAD RESET WITH 4" x 30" CAST IRON MONUMENT WITH COUNTY SURVEYOR CAP

B. Description of corner evidence found and/or method applied in restoring or reestablishing corner:


FOUND 4" CAST IRON MONUMENT WITH COUNTY SURVEYOR CAP
ACCEPTED POSITION OF EXISTING CAP DUE TO HISTORICAL USAGE AND DOCUMENTATION
ORIGIN UNCERTAIN

POSITION OF SAID
 RECORDED CORNER
 REVIEWED & RATIFIED
 BY MUSKEGON COUNTY
 PEER GROUP IN ACCORDANCE
 WITH P.A. 345, OF 1990

Mar 1, 1994 sv

C. Description of monument for corner and accessories established to perpetuate locating the position of the corner:

- 4" CAST IRON MONUMENT WITH COUNTY SURVEY CAP
- S 5.20' ± CENTER LINE OF ABANDONED RAIL ROAD
- S 45 DEGREES E 99.30' EAST EDGE OF NE LEG OF TOWER
- N 15 DEGREES E 128.32' NAIL IN POWER POLE
- N 40 DEGREES E 52.60' FENCE POST

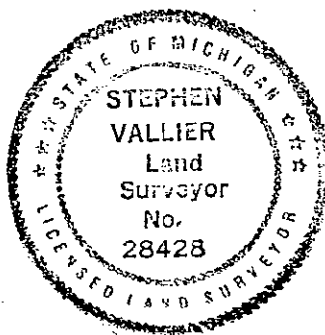

Signed by *Stephen Vallier*

Date *Mar 1, 1994*

Surveyor's Michigan License No. 28428