

APR 28 1995

LAND CORNER RECORDATION CERTIFICATE
COMMISSION Filing Requirement of Act 74, Mich. P.A. 1970

For corners in
MUSKEGON
(County)

Located In: Corner Code #

1. Public Land Survey	T 9 R 15	K-5
	T R	
	T R	
	T R	
2. Property Controlling in Section	S T R	
	S T R	
3. Miscellaneous Property in Sec.	S T R	
	S T R	

STATE OF MICHIGAN
COUNTY OF MUSKEGON
RECEIVED FOR RECORD

1994 DEC 29 AM 10:09

Carlie Carter
REGISTER OF DEEDS

A1559

Register of Deeds Stamp & File Number

4. Lot No. _____, Recorded Plat _____
5. Private Claims _____

A	B	C	D	E	F	G	H	I	J	K	L	M
2	6	5	4	3	2	1						
3												
4	7	8	9	10	11	12						
5												
6	18	17	16	15	14	13						
7												
8	19	20	21	22	23	24						
9												
10	30	29	28	27	26	25						
11												
12	31	32	33	34	35	36						
13												

I, STEPHEN V. VALLIER in a field survey on JULY, 1994, do hereby certify that under requirements of P.A. 74, Michigan P.A. of 1970, the corner points mentioned in lines 1 and 2 above were in conformance with regulations and rules therefore as required in the current manual of survey instructions of the United States Department of the Interior, Bureau of Land Management or by a decree of a Court of Law and/or that the corner points mentioned in lines 3, 4 and 5 above were in conformance with the rules of the Michigan Board of Land Surveyors or by a Decree of a Court of Law; established, re-established, monumented, re-monumented, recovered, found as expressed below:

NOTE: Not more than 4 corners, all in the same town and range, may be recorded on this certificate.

A. Description of original monument and accessories and/or subsequent restoration:
 1837 GLO SET SECTION CORNER
 1950's MUSKEGON COUNTY ROAD COMMISSION TIE MAP - IRON PIPE
 1975 C.P. ENGLORT LIBER 1053 PAGE 232, FOUND RAIL ROAD SPIKE
 1985 C.F. LEWANDOWSKI LIBER 1318 PAGE 917, FOUND RAIL ROAD SPIKE
 ON 1 1/2" IRON PIPE, RESET 4" CAST IRON MONUMENT WITH COUNTY SURVEY CAP

B. Description of corner evidence found and/or method applied in restoring or reestablishing corner:
 FOUND 4" CAST IRON MONUMENT WITH COUNTY SURVEYOR CAP
 ACCEPTED POSITION OF EXISTING MONUMENT DUE TO HISTORICAL USAGE AND CONSISTENT DOCUMENTATION FOR 50 YEAR ± PERIOD.


POSITION OF SAID
RECORDED CORNER
REVIEWED & RATIFIED
BY MUSKEGON COUNTY
PEER GROUP IN ACCORDANCE
WITH P.A. 345, OF 1990

Mar 1, 1994

C. Description of monument for corner and accessories established to perpetuate locating the position of the corner:

4" CAST IRON MONUMENT WITH COUNTY SURVEY CAP.

- S 52 deg. W 64.26' 8" White Pine with nail
- N 22 deg. E 73.35' 30" Maple with nail
- S 43 deg. E 41.29' 20" Maple with nail
- N 28 deg. W 60.37' 28" Maple with nail

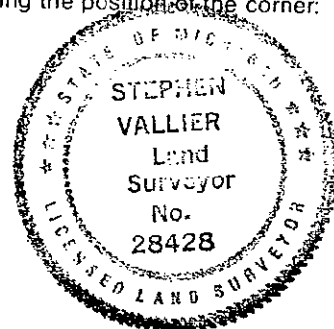

Signed by *Stephen Vallier* Date *Dec 27, 1994*
 Surveyor's Michigan License No. 28428