

**SURVEY &
REMONUMENTATION**

LIBER 1810 PAGE 536

APR 28 1995

**LAND CORNER RECORDATION CERTIFICATE
Filing Requirement of Act 74, Mich. P.A. 1970**

For corners in **COMMISSION**
MUSKEGON
(County)

Located In: Corner Code #

- | | | |
|------------------------------------|-------------------------|-------|
| 1. Public Land Survey | T <u>9</u> R <u>15</u> | K-6 |
| | T _____ R _____ | _____ |
| | T _____ R _____ | _____ |
| | T _____ R _____ | _____ |
| 2. Property Controlling in Section | S _____ T _____ R _____ | _____ |
| | S _____ T _____ R _____ | _____ |
| 3. Miscellaneous Property in Sec. | S _____ T _____ R _____ | _____ |
| | S _____ T _____ R _____ | _____ |

A1560

1994 DEC 29 AM 10:09
 REGISTER OF DEEDS
 STATE OF MICHIGAN
 COUNTY OF MUSKEGON
 RECEIVED FOR RECORD

Register of Deeds Stamp & File Number

4. Lot No. _____, Recorded Plat _____
 5. Private Claims _____

I, **STEPHEN V. VALLIER** in a field survey on JULY 1994, do hereby certify that under requirements of P.A. 74, Michigan P.A. of 1970, the corner points mentioned in lines 1 and 2 above were in conformance with regulations and rules therefore as required in the current manual of survey instructions of the United States Department of the Interior, Bureau of Land Management or by a decree of a Court of Law and/or that the corner points mentioned in lines 3, 4 and 5 above were in conformance with the rules of the Michigan Board of Land Surveyors or by a Decree of a Court of Law; established, re-established, monumented, re-monumented, recovered, found as expressed below:

	A	B	C	D	E	F	G	H	I	J	K	L	M
2	6		5		4		3		2		1		
3													
4	7		8		9		10		11		12		
5													
6	18		17		16		15		14		13		
7													
8	19		20		21		22		23		24		
9													
10	30		29		28		27		26		25		
11													
12	31		32		33		34		35		36		

NOTE: Not more than 4 corners, all in the same town and range, may be recorded on this certificate.

A. Description of original monument and accessories and/or subsequent restoration:

- 1837 CORNER SET BY GLO
- 1950's MUSKEGON COUNTY ROAD COMMISSION TIE MAP IRON ROD
- 1975 MUSKEGON COUNTY ROAD COMMISSION LBR. 1064 PG. 560 2" IRON PIPE
- 1985 C.F. LEWANDOWSKI LBR. 1318 PG. 917, FOUND RAIL ROAD SPIKE ON TOP OF 2" IRON PIPE, RESET WITH 4" X 30" CAST IRON MONUMENT WITH COUNTY SURVEYOR CAP

B. Description of corner evidence found and/or method applied in restoring or reestablishing corner:


FOUND 4" CAST IRON MONUMENT WITH COUNTY SURVEY CAP
 ACCEPTED POSITION OF CORNER, APPEARS CORNER WAS SET BY SINGLE PROPORTIONATE MEANS. HISTORICAL USAGE SUPPORTS THIS CORNER.

POSITION OF SAID
 RECORDED CORNER
 REVIEWED & RATIFIED
 BY MUSKEGON COUNTY
 PEER GROUP IN ACCORDANCE
 WITH P.A. 345, OF 1990

Mar 1, 1994

C. Description of monument for corner and accessories established to perpetuate locating the position of the corner:

- 4" CAST IRON MONUMENT WITH COUNTY SURVEY CAP
- N30°E 50.96' 24" MAPLE WITH NAIL
- S20E 108.05' POWER POLE WITH NAIL
- E 30.41' FENCE POST
- N60°W 52.94' 10" PINE WITH NAIL

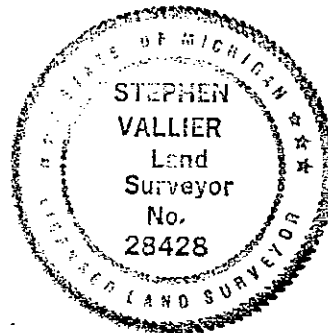

Signed by *Stephen Vallier* Date *Dec 27, 1994*
 Surveyor's Michigan License No. 28428