

APR 28 1995

LAND CORNER RECORDATION CERTIFICATE
Filing Requirement of Act 74, Mich. P.A. 1970

COMMISSION

For corners in

<u>Muskegon</u> <small>(County)</small>	Located In:	Corner Code #/
1. Public Land Survey	T <u>9</u> R <u>15</u>	<u>K-11</u>
	T _____ R _____	_____
	T _____ R _____	_____
	T _____ R _____	_____
2. Property Controlling in Section	S _____ T _____ R _____	_____
	S _____ T _____ R _____	_____
3. Miscellaneous Property in Sec.	S _____ T _____ R _____	_____
	S _____ T _____ R _____	_____

STATE OF MICHIGAN
COUNTY OF MUSKEGON
REGISTERED FOR RECORD

DEC 29 AM 10:11

Carole Carter
REGISTER OF DEEDS

A1585

Register of Deeds Stamp & File Number

4. Lot No. _____, Recorded Plat _____

5. Private Claims _____

A	B	C	D	E	F	G	H	I	J	K	L	M
2	6	5	4	3	2	1						
3												
4	7	8	9	10	11	12						
5												
6	18	17	16	15	14	13						
7												
8	19	20	21	22	23	24						
9												
10	30	29	28	27	26	25						
11												
12	31	32	33	34	35	36						
13												

I, Stephen V. Vallier, in a field survey on November, 1994, do hereby certify that under requirements of P.A. 74, Michigan P.A. of 1970, the corner points mentioned in lines 1 and 2 above were in conformance with regulations and rules therefore as required in the current manual of survey instructions of the United States Department of the Interior, Bureau of Land Management or by a decree of a Court of Law and/or that the corner points mentioned in lines 3, 4 and 5 above were in conformance with the rules of the Michigan Board of Land Surveyors or by a Decree of a Court of Law; established, re-established, monumented, re-monumented, recovered, found as expressed below:

NOTE: Not more than 4 corners, all in the same town and range, may be recorded on this certificate.

A. Description of original monument and accessories and/or subsequent restoration:
 1837 GLO set Section Corner
 1950's M.C.R.C. tie map (witnesses only)
 1982, C.F. Lewandowski Liber 1242 Page 319 Found 1" solid iron - Reset with C.I. Monument with County Survey Cap.


B. Description of corner evidence found and/or method applied in restoring or reestablishing corner:
 Found 4" C.I. Monument with County Survey Cap.
 Accepted position of corner due to historical usage and consistent documentation.

POSITION OF SAID RECORDED CORNER REVIEWED & RATIFIED BY MUSKEGON COUNTY PEER GROUP IN ACCORDANCE WITH P.A. 345, OF 1990

Oct 4, 1994 SW

C. Description of monument for corner and accessories established to perpetuate locating the position of the corner:
 4" Cast Iron Monument with County Survey Cap.

- N 35 deg W 28.32' 36" Oak with nail
- N 15 deg W 86.00' 18" Spruce with nail
- S 50 deg E 38.55' Light Pole with nail
- N 52 deg E 82.60' 10" Spruce with nail

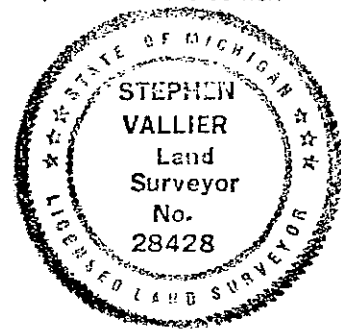

Signed by *Stephen Vallier* Date Dec 27, 1994
 Surveyor's Michigan License No. 28428