

**SURVEY &  
REMONUMENTATION**

LIBER. **1810** PAGE **537**

APR 28 1995

**LAND CORNER RECORDATION CERTIFICATE**  
Filing Requirement of Act 74, Mich. P.A. 1970

For corners in

MUSKEGON **COMMISSION**  
(County)

Located In:

Corner Code #

- |                                    |            |             |            |
|------------------------------------|------------|-------------|------------|
| 1. Public Land Survey              | T <u>9</u> | R <u>15</u> | <u>L-1</u> |
|                                    | T          | R           |            |
|                                    | T          | R           |            |
|                                    | T          | R           |            |
| 2. Property Controlling in Section | S          | T           | R          |
|                                    | S          | T           | R          |
| 3. Miscellaneous Property in Sec.  | S          | T           | R          |
|                                    | S          | T           | R          |

*A1561*

STATE OF MICHIGAN  
COUNTY OF MUSKEGON  
RECEIVED FOR RECORD  
1994 DEC 29 AM 10: 09  
*Robin Carter*  
REGISTER OF DEEDS  
Register of Deeds Stamp & File Number

4. Lot No. \_\_\_\_\_, Recorded Plat \_\_\_\_\_  
5. Private Claims \_\_\_\_\_

	A	B	C	D	E	F	G	H	I	J	K	L	M
2	6	5	4	3	2	1							
3													
4	7	8	9	10	11	12							
5													
6	18	17	16	15	14	13							
7													
8	19	20	21	22	23	24							
9													
10	30	29	28	27	26	25							
11													
12	31	32	33	34	35	36							
13													

I, Stephen Vallier, in a field survey on December, 19 94, do hereby certify that under requirements of P.A. 74, Michigan P.A. of 1970, the corner points mentioned in lines 1 and 2 above were in conformance with regulations and rules therefore as required in the current manual of survey instructions of the United States Department of the Interior, Bureau of Land Management or by a decree of a Court of Law and/or that the corner points mentioned in lines 3, 4 and 5 above were in conformance with the rules of the Michigan Board of Land Surveyors or by a Decree of a Court of Law; established, re-established, monumented, re-monumented, recovered, found as expressed below:

**NOTE: Not more than 4 corners, all in the same town and range, may be recorded on this certificate.**

A. Description of original monument and accessories and/or subsequent restoration:

- Corner not set by GLO  
1972 C. F. Lewandowski found 1/2" iron pipe apparently set as single proportionate measurement  
1982 C. F. Lewandowski Lbr. 1242 Pg. 298 found 1/2" iron pipe - reset with 4" X 30" castiron monument with county survey cap


B. Description of corner evidence found and/or method applied in restoring or reestablishing corner:

Found 4" castiron monument with county survey cap - Accepted position of existing corner set by acceptable survey methods, although origin is undetermined. Further agrees with occupation.

POSITION OF SAID  
RECORDED CORNER  
REVIEWED & RATIFIED  
BY MUSKEGON COUNTY  
PEER GROUP IN ACCORDANCE  
WITH P.A. 345, OF 1990  
*Mar 1 1994*

C. Description of monument for corner and accessories established to perpetuate localing the position of the corner:

- 4" castiron monument with county survey cap
- |            |        |   |
|------------|--------|---|
| E          | 9.90'  | 4" castiron monument L.S.W. corner Section 36 T10N R15W |
| 568 Deg. W | 33.64' | 6" Poplar   |
| 525 Deg. W | 54.32' | 6" Poplar   |
| 530 Deg. E | 73.08' | 12" Pine  |

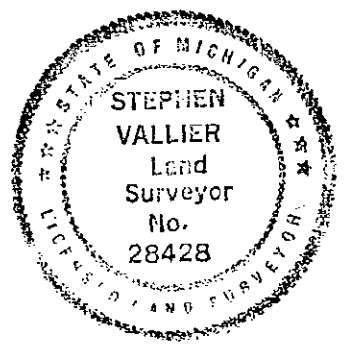

Signed by *Stephen Vallier* Date *Dec 27, 1994*  
Surveyor's Michigan License No. 28428