

**SURVEY &
REMONUMENTATION**

LIBER 1810 PAGE 19

APR 28 1995

COMMISSION

LAND CORNER RECORDATION CERTIFICATE
Filing Requirement of Act 74, Mich. P.A. 1970

For corners in
MUSKEGON
(County)

Located In: Corner Code #

- | | | | | | | |
|---------------------------------------|---|----|---|-----|-----|-----|
| 1. Public Land Survey | T | 9N | R | 15W | L-4 | |
| | T | | R | | | |
| | T | | R | | | |
| | T | | R | | | |
| 2. Property Controlling
in Section | S | 12 | T | 9N | R | 15W |
| | S | | T | | R | |
| 3. Miscellaneous
Property in Sec. | S | | T | | R | |

A1526

STATE OF MICHIGAN
COUNTY OF MUSKEGON
RECEIVED FOR RECORD
1994 DEC 27 AM 11:40
Doris Carter
REGISTER OF DEEDS
Register of Deeds Stamp & File Number

4. Lot No. _____, Recorded Plat _____
5. Private Claims _____

A	B	C	D	E	F	G	H	I	J	K	L	M
2	6	5	4	3	2	1						
3												
4	7	8	9	10	11							
5												
6	18	17	16	15	14	13						
7												
8	19	20	21	22	23	24						
9												
10	30	29	28	27	26	25						
11												
12	31	32	33	34	35	36						
13												

I, Stephen V. Vallier, in a field survey on July, 1994, do hereby certify that under requirements of P.A. 74, Michigan P.A. of 1970, the corner points mentioned in lines 1 and 2 above were in conformance with regulations and rules therefore as required in the current manual of survey instructions of the United States Department of the Interior, Bureau of Land Management or by a decree of a Court of Law and/or that the corner points mentioned in lines 3, 4 and 5 above were in conformance with the rules of the Michigan Board of Land Surveyors or by a Decree of a Court of Law; established, re-established, monumented, re-monumented, recovered, found as expressed below:

NOTE: Not more than 4 corners, all in the same town and range, may be recorded on this certificate.

A. Description of original monument and accessories and/or subsequent restoration:

1918 ERA GRAND TRUNK WESTERN RAILROAD MAP - IRON IN CENTERLINE OF RAILROAD
CORNER NOT SET BY GLO

B. Description of corner evidence found and/or method applied in restoring or reestablishing corner:


TRACKS ABANDONED - NO EVIDENCE OF IRON IN CENTERLINE OF RAILROAD - INTERSECTION OF 1/4 LINES FALLS NORTH OF RAILROAD RIGHT OF WAY. ESTABLISHED CORNER AT INTERSECTION OF NORTH-SOUTH 1/4 LINE AND EAST-WEST 1/4 LINE

POSITION OF SAID
RECORDED CORNER
REVIEWED & RATIFIED
BY MUSKEGON COUNTY
PEER GROUP IN ACCORDANCE
WITH P.A. 345, OF 1990

Mar. 1, 1994 SW

C. Description of monument for corner and accessories established to perpetuate locating the position of the corner:

- SET 3 3/4" X 30" CAST IRON MONUMENT WITH COUNTY SURVEYOR CAP
- | | | |
|---------|---------|-----------------------|
| N 25° E | 542.95' | NAIL IN P. POLE |
| N 73° E | 516.42' | NAIL IN P. POLE |
| S 65° E | 92.69' | NAIL IN 12" TWIN PINE |
| S 54° E | 62.48' | NAIL IN 8" TWIN PINE |
| S 33° W | 44.32' | NAIL IN 14" PINE |

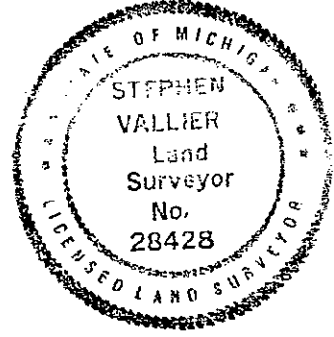

Signed by Stephen Vallier

Date Dec 27, 1994

Surveyor's Michigan License No. 28428