

**SURVEY &
REMONUMENTATION**

LIBER 1810 PAGE 539

APR 28 1995

**LAND CORNER RECORDATION CERTIFICATE
Filing Requirement of Act 74, Mich. P.A. 1970**

For corners in **COMMISSION**

<u>Muskegon</u> <small>(County)</small>	Located In:	Corner Code #
1. Public Land Survey	T <u>9</u> R <u>15</u>	<u>L-5</u>
	T _____ R _____	_____
	T _____ R _____	_____
	T _____ R _____	_____
2. Property Controlling in Section	S _____ T _____ R _____	_____
	S _____ T _____ R _____	_____
3. Miscellaneous Property in Sec.	S _____ T _____ R _____	_____
	S _____ T _____ R _____	_____
4. Lot No. _____, Recorded Plat _____		
5. Private Claims _____		

A1563

STATE OF MICHIGAN
 COUNTY OF MUSKEGON
 RECEIVED FOR RECORD
 1994 DEC 29 AM 10:09
Carrie Carter
 REGISTER OF DEEDS

Register of Deeds Stamp & File Number

I, Stephen V. Vallier, in a field survey on July, 19 94, do hereby certify that under requirements of P.A. 74, Michigan P.A. of 1970, the corner points mentioned in lines 1 and 2 above were in conformance with regulations and rules therefore as required in the current manual of survey instructions of the United States Department of the Interior, Bureau of Land Management or by a decree of a Court of Law and/or that the corner points mentioned in lines 3, 4 and 5 above were in conformance with the rules of the Michigan Board of Land Surveyors or by a Decree of a Court of Law; established, re-established, monumented, re-monumented, recovered, found as expressed below:

NOTE: Not more than 4 corners, all in the same town and range, may be recorded on this certificate.

A	B	C	D	E	F	G	H	I	J	K	L	M
2	6	5	4	3	2	1						
3												
4	7	8	9	10	11	12						
5												
6	18	17	16	15	14	13						
7												
8	19	20	21	22	23	24						
9												
10	30	29	28	27	26	25						
11												
12	31	32	33	34	35	36						
13												

A. Description of original monument and accessories and/or subsequent restoration:

- 1837 GLO Set quarter corner
- 1983 D. Schiele Lbr. 1355 Pg. 473 found 1 3/4" metal with rounded head
- 1985 C. F. Lewandowski Lbr. 1318 Pg. 916 found 1 1/2" farm hitch - Reset 4" X 30' cast iron monument with cast iron survey cap.

B. Description of corner evidence found and/or method applied in restoring or reestablishing corner:

Found 4" cast iron monument with county survey cap. Accepted position of existing corner by historical usage. Origin uncertain by appears to have been attempted to be set by single proportionate measure.


POSITION OF SAID
 RECORDED CORNER
 REVIEWED & RATIFIED
 BY MUSKEGON COUNTY
 PEER GROUP IN ACCORDANCE
 WITH P.A. 345, OF 1990

Mar 1, 1994 sm

C. Description of monument for corner and accessories established to perpetuate locating the position of the corner:

4" Cast Iron Monument

- | | | |
|-------------|---------|-----------------------|
| N 70 Deg. E | 73.45' | Dead Cherry with nail |
| S 70 Deg. W | 140.87' | Nail in P. Pole |
| N | 28.26' | Steel post |
| S | 30.26' | Fence post with rail |

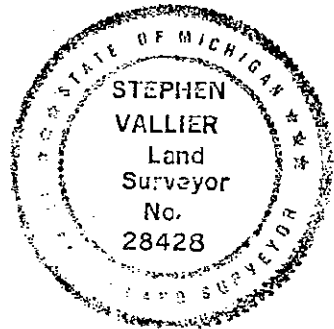

Signed by *Steph Vallier* Date *Dec 27, 1994*

Surveyor's Michigan License No. 28428