

SURVEY & REMONUMENTATION

LIBER **1810** PAGE **20**

APR 28 1995

COMMISSION LAND CORNER RECORDATION CERTIFICATE
 Filing Requirement of Act 74, Mich. P.A. 1970

For corners in

MUSKEGON
(County)

Located In:

Corner Code #

- | | | |
|------------------------------------|--------------------------------------|------------|
| 1. Public Land Survey | T <u>9N</u> R <u>R15W</u> | <u>L-6</u> |
| | T _____ R _____ | _____ |
| | T _____ R _____ | _____ |
| | T _____ R _____ | _____ |
| 2. Property Controlling in Section | S <u>13</u> T <u>9N</u> R <u>15W</u> | _____ |
| | S _____ T _____ R _____ | _____ |
| 3. Miscellaneous Property in Sec. | S _____ T _____ R _____ | _____ |
| | S _____ T _____ R _____ | _____ |

A1527

STATE OF MICHIGAN
 COUNTY OF MUSKEGON
 REGISTERED FOR RECORD
 1994 DEC 27 AM 11:40
Doris Carter
 REGISTER OF DEEDS

Register of Deeds Stamp & File Number

4. Lot No. _____, Recorded Plat _____
 5. Private Claims _____

	A	B	C	D	E	F	G	H	I	J	K	L	M
2	6	5	4	3	2	1							
3													
4	7	8	9	10	11	12							
5													
6	18	17	16	15	14	13							
7													
8	19	20	21	22	23	24							
9													
10	30	29	28	27	26	25							
11													
12	31	32	33	34	35	36							
13													

I, **STEPHEN V. VALLIER**, in a field survey on DECEMBER, 19 94, do hereby certify that under requirements of P.A. 74, Michigan P.A. of 1970, the corner points mentioned in lines 1 and 2 above were in conformance with regulations and rules therefore as required in the current manual of survey instructions of the United States Department of the Interior, Bureau of Land Management or by a decree of a Court of Law and/or that the corner points mentioned in lines 3, 4 and 5 above were in conformance with the rules of the Michigan Board of Land Surveyors or by a Decree of a Court of Law; established, re-established, monumented, re-monumented, recovered, found as expressed below:

NOTE: Not more than 4 corners, all in the same town and range, may be recorded on this certificate.

A. Description of original monument and accessories and/or subsequent restoration:
IRON MUSKEGON COUNTY ROAD COMMISSION 1950 - NO WITNESSES

CORNER NOT SET BY GLO


B. Description of corner evidence found and/or method applied in restoring or reestablishing corner:
FOUND 1/2" X 18" IRON ON NORTH-SOUTH BRUSH ROW AND EAST-WEST DITCH EXTENSION. BRUSH EAST-WEST APPROXIMATELY 22' SOUTH OF CORNER

FOUND CORNER ON N-3, 1/4 LINE AND 24.32' SOUTH OF E-W 1/4 LINE

Mar 1, 1994 SW

POSITION OF SAID
 RECORDED CORNER
 REVIEWED & RATIFIED
 BY MUSKEGON COUNTY
 FEER GROUP IN ACCORDANCE
 WITH P.A. 345, OF 1990

C. Description of monument for corner and accessories established to perpetuate locating the position of the corner:
REPLACED FOUND 1/2" IRON AND SET 2 3/4" X 30" CAST IRON MONUMENT WITH COUNTY SURVEYOR CAP
 S 2° W 22.05' P. POLE (NAIL EAST SIDE)
 N 35° E 38.25' P. POLE (NAIL SE'LY SIDE)
 N 8° E 13.79' P. POLE (NAIL E. SIDE)

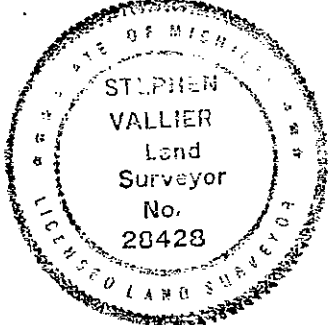

Signed by *Stephen Vallier* Date *Dec 27, 1994*
 Surveyor's Michigan License No. 28428