

LAND CORNER RECORDATION CERTIFICATE  
Filing Requirement of Act 74, Mich. P.A. 1970

For corners in

MUSKEGON

(County)

Located In:

Corner Code #:

- |                                    |   |    |   |     |        |
|------------------------------------|---|----|---|-----|--------|
| 1. Public Land Survey              | T | 9N | R | 15W | L-7    |
|                                    | T |    | R |     |        |
|                                    | T |    | R |     |        |
|                                    | T |    | R |     |        |
| 2. Property Controlling in Section | S |    | T |     | Reg-#1 |
|                                    | S |    | T |     |        |
| 3. Miscellaneous Property in Sec.  | S |    | T |     |        |
|                                    | S |    | T |     |        |

1994 DEC 29 AM 10:09  
 REGISTER OF DEEDS  
 STATE OF MICHIGAN  
 COUNTY OF MUSKEGON  
 RECEIVED FOR RECORD  
 Register of Deeds Stamp & File Number  
 A1564  
 Debbie Carter

4. Lot No. \_\_\_\_\_, Recorded Plat \_\_\_\_\_
5. Private Claims \_\_\_\_\_

|    | A  | B  | C  | D  | E  | F  | G | H | I | J | K | L | M |
|----|----|----|----|----|----|----|---|---|---|---|---|---|---|
| 2  | 6  | 5  | 4  | 3  | 2  | 1  |   |   |   |   |   |   |   |
| 3  |    |    |    |    |    |    |   |   |   |   |   |   |   |
| 4  | 7  | 8  | 9  | 10 | 11 | 12 |   |   |   |   |   |   |   |
| 5  |    |    |    |    |    |    |   |   |   |   |   |   |   |
| 6  | 18 | 17 | 16 | 15 | 14 | 13 |   |   |   |   |   |   |   |
| 7  |    |    |    |    |    |    |   |   |   |   |   |   |   |
| 8  | 19 | 20 | 21 | 22 | 23 | 24 |   |   |   |   |   |   |   |
| 9  |    |    |    |    |    |    |   |   |   |   |   |   |   |
| 10 | 30 | 29 | 28 | 27 | 26 | 25 |   |   |   |   |   |   |   |
| 11 |    |    |    |    |    |    |   |   |   |   |   |   |   |
| 12 | 31 | 32 | 33 | 34 | 35 | 36 |   |   |   |   |   |   |   |
| 13 |    |    |    |    |    |    |   |   |   |   |   |   |   |

STEPHEN V. VALLIER, in a field survey on JULY, 19 94, do hereby certify that under requirements of P.A. 74, Michigan P.A. of 1970, the corner points mentioned in lines 1 and 2 above were in conformance with regulations and rules therefore as required in the current manual of survey instructions of the United States Department of the Interior, Bureau of Land Management or by a decree of a Court of Law and/or that the corner points mentioned in lines 3, 4 and 5 above were in conformance with the rules of the Michigan Board of Land Surveyors or by a Decree of a Court of Law; established, re-established, monumented, re-monumented, recovered, found as expressed below:

NOTE: Not more than 4 corners, all in the same town and range, may be recorded on this certificate.

A. Description of original monument and accessories and/or subsequent restoration:

- 1837 GLO SET 1/4 CORNER
- 1983 D. SCHIELE, LBR. 1255, PG. 473 SET CAPPED IRON AS LOST CORNER MID-WAY ON LINE BETWEEN SW & SE CORNER SECTION 13
- 1984 C.F. LEWANDOWSKI LBR. 1301, PG. 589 FOUND CAPPED IRON-RESET CAST IRON MONUMENT 4" X 30" WITH COUNTY SURVEY CAP

B. Description of corner evidence found and/or method applied in restoring or reestablishing corner:

FOUND 4" CAST IRON MON. WITH COUNTY SURVEY CAP  
ACCEPTED POSITION OF CORNER AND METHOD OF 1983 Establishment as Lost Corner.

SURVEY &  
REMONUMENTATION

FEB 01 1999


SECTION

POSITION OF SAID  
RECORDED CORNER  
REVIEWED & RATIFIED  
BY MUSKEGON COUNTY  
PEER GROUP IN ACCORDANCE  
WITH P.A. 345, OF 1990

Mar 1 1994 SW

C. Description of monument for corner and accessories established to perpetuate locating the position of the corner:

- 4" CAST IRON MON. WITH COUNTY SURVEY CAP
- S 25° E 55.70' 12" MAPLE
- S 35° W 49.25' G. POLE
- N 35° W 48.20' USGS
- N 35° E 70.90' P. POLE

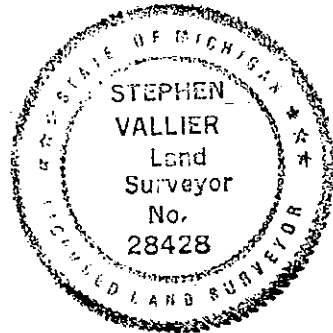

Signed by Stephen Vallier  
Surveyor's Michigan License No. 28428

Date Dec 27, 1994