

**SURVEY &
REMONUMENTATION**

LIBER 1810 PAGE 542

APR 28 1995

**LAND CORNER RECORDATION CERTIFICATE
Filing Requirement of Act 74, Mich. P.A. 1970**

STATE OF MICHIGAN
 COUNTY OF MUSKEGON
 RECEIVED FOR RECORD
 1994 DEC 29 AM 10:10
Corrie Corbett
 REGISTER OF DEEDS

For corners in **COMMISSION**
MUSKEGON
 (County)

Located In: Corner Code #

1. Public Land Survey	T	9N	R	15W	L-9
	T		R		
	T		R		
	T		R		
2. Property Controlling in Section	S		T	R	
	S		T	R	
3. Miscellaneous Property in Sec.	S		T	R	
	S		T	R	

A1566

Register of Deeds Stamp & File Number

4. Lot No. _____, Recorded Plat _____
 5. Private Claims _____

	A	B	C	D	E	F	G	H	I	J	K	L	M
2	6		5		4		3		2		1		
3													
4	7		8		9		10		11		12		
5													
6	18		17		16		15		14		13		
7													
8	19		20		21		22		23		24		
9													
10	30		29		28		27		26		25		
11													
12	31		32		33		34		35		36		
13													

STEPHEN V. VALLIER, in a field survey on **NOVEMBER**, 19 **94**, do hereby certify that under requirements of P.A. 74, Michigan P.A. of 1970, the corner points mentioned in lines 1 and 2 above were in conformance with regulations and rules therefore as required in the current manual of survey instructions of the United States Department of the Interior, Bureau of Land Management or by a decree of a Court of Law and/or that the corner points mentioned in lines 3, 4 and 5 above were in conformance with the rules of the Michigan Board of Land Surveyors or by a Decree of a Court of Law; established, re-established, monumented, re-monumented, recovered, found as expressed below:

NOTE: Not more than 4 corners, all in the same town and range, may be recorded on this certificate.

A. Description of original monument and accessories and/or subsequent restoration:

- 1837 GLO SET 1/4 CORNER
- 1983 D. SCHIELE, LBR. 1255, PG. 475 FOUND BENT IRON PIPE-REPLACED WITH CAPPED STEEL BAR
- 1983 C.F. LEWANDOWSKI, LBR. 1297, PG. 939 FOUND CAPPED IRON-RESET WITH 4" X 30" CAST IRON MONUMENT WITH COUNTY SURVEY CAP

B. Description of corner evidence found and/or method applied in restoring or reestablishing corner:

FOUND 4" CAST IRON MONUMENT WITH COUNTY SURVEY CAP
 ACCEPTED POSITION OF EXISTING CORNER DUE TO HISTORICAL USAGE AND DOCUMENTATION. ORIGIN UNCERTAIN.


POSITION OF SAID
 RECORDED CORNER
 REVIEWED & RATIFIED
 BY MUSKEGON COUNTY
 PEER GROUP IN ACCORDANCE
 WITH P.A. 345, OF 1990

DEC 4, 1994

C. Description of monument for corner and accessories established to perpetuate locating the position of the corner:

4" CAST IRON MONUMENT WITH COUNTY SURVEY CAP

- N 60° W 37.59' 14" CHERRY
- N 40° W 24.15' CHERRY CLUMP
- N 60° E 28.05' 10" ASPEN
- S 30° E 47.43' 8" ASPEN

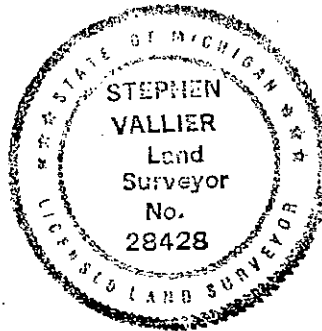

Signed by *Stephen Vallier* Date *Dec 27, 1994*

Surveyor's Michigan License No. 8428