

SURVEY & REMONUMENTATION

LIBER **1810** PAGE **548**

APR 28 1995

COMMISSION

LAND CORNER RECORDATION CERTIFICATE
Filing Requirement of Act 74, Mich. P.A. 1970

For corners in

MUSKEGON Located In: Corner Code ##
(County)

1. Public Land Survey	T <u>9</u> R <u>15</u>	<u>M-5</u>
	T _____ R _____	_____
	T _____ R _____	_____
	T _____ R _____	_____
2. Property Controlling in Section	S _____ T _____ R _____	_____
	S _____ T _____ R _____	_____
3. Miscellaneous Property in Sec.	S _____ T _____ R _____	_____
	S _____ T _____ R _____	_____
4. Lot No. _____, Recorded Plat _____		
5. Private Claims _____		

STATE OF MICHIGAN
 COUNTY OF MUSKEGON
 RECEIVED FOR RECORD
 1994 DEC 29 AM 10:10
Cassie Carter
 REGISTER OF DEEDS
 Register of Deeds Stamp & File Number

A 1572

A	B	C	D	E	F	G	H	I	J	K	L	M
2	5	5	4	3	2	1						
3												
4	7	8	9	10	11	12						
5												
6	18	17	16	15	14	13						
7												
8	19	20	21	22	23	24						
9												
10	30	29	28	27	26	25						
11												
12	31	32	33	34	35	36						
13												

I, STEPHEN V. VALLIER in a field survey on JULY, 1994, do hereby certify that under requirements of P.A. 74, Michigan P.A. of 1970, the corner points mentioned in lines 1 and 2 above were in conformance with regulations and rules therefore as required in the current manual of survey instructions of the United States Department of the Interior, Bureau of Land Management or by a decree of a Court of Law and/or that the corner points mentioned in lines 3, 4 and 5 above were in conformance with the rules of the Michigan Board of Land Surveyors or by a Decree of a Court of Law; established, re-established, monumented, re-monumented, recovered, found as expressed below:

NOTE: Not more than 4 corners, all in the same town and range, may be recorded on this certificate.


A. Description of original monument and accessories and/or subsequent restoration:
 1837 GLO SET SECTION CORNER
 1950's MUSKEGON COUNTY ROAD COMMISSION TIE MAP--IRON PIPE
 1985 C.F. LEWANDOWSKI LIBER 1318, PAGE 916
 FOUND 1 1/2" IRON PIPE RESET 4" x 30" CAST IRON MONUMENT WITH COUNTY SURVEY CAP

B. Description of corner evidence found and/or method applied in restoring or reestablishing corner:
 FOUND 4" CAST IRON MONUMENT - ACCEPTED POSITION OF CORNER DUE TO HISTORICAL USAGE AND DOCUMENTATION

POSITION OF SAID RECORDED CORNER REVIEWED & RATIFIED BY MUSKEGON COUNTY PEER GROUP IN ACCORDANCE WITH P.A. 315, OF 1990

Mar 1, 1994 su

C. Description of monument for corner and accessories established to perpetuate locating the position of the corner:
 4" CAST IRON MONUMENT / CAP MISSING
 N20 DEG.E 134' ± POWER POLE WITH NAIL
 S55 DEG.E 56.83' POWER POLE WITH NAIL
 S35 DEG.W 39.83' ROAD SIGN
 NORTH 2641.57' DISTANCE TO E1/4 CORNER SECTION 1
 WEST 2509.64' DISTANCE TO S1/4 CORNER SECTION 1

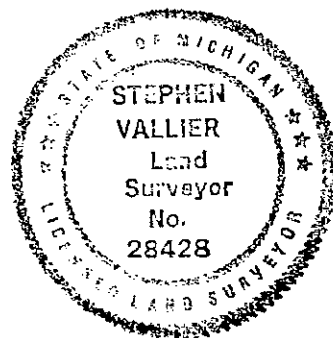

Signed by *Stephen Vallier* Date Dec 27, 1994
 Surveyor's Michigan License No. 28428