

**SURVEY &  
REMONUMENTATION**

LIBER **1810** PAGE **549**

APR 28 1995

**LAND CORNER RECORDATION CERTIFICATE**  
Filing Requirement of Act 74, Mich. P.A. 1970

For corners in **COMMISSION**  
MUSKEGON  
(County)

Located In: \_\_\_\_\_ Corner Code =# \_\_\_\_\_

- |                                    |                         |            |
|------------------------------------|-------------------------|------------|
| 1. Public Land Survey              | T <u>9</u> R <u>15</u>  | <u>M-6</u> |
|                                    | T _____ R _____         | _____      |
|                                    | T _____ R _____         | _____      |
|                                    | T _____ R _____         | _____      |
| 2. Property Controlling in Section | S _____ T _____ R _____ | _____      |
|                                    | S _____ T _____ R _____ | _____      |
| 3. Miscellaneous Property in Sec.  | S _____ T _____ R _____ | _____      |
|                                    | S _____ T _____ R _____ | _____      |

*A1573*

STATE OF MICHIGAN  
 COUNTY OF MUSKEGON  
 RECEIVED FOR RECORD  
 1994 DEC 29 AM 10:10  
*Carrie Carter*  
 REGISTER OF DEEDS

Register of Deeds Stamp & File Number

4. Lot No. \_\_\_\_\_, Recorded Plat \_\_\_\_\_  
 5. Private Claims \_\_\_\_\_

	A	B	C	D	E	F	G	H	I	J	K	L	M
2	6		5		4		3		2		1		
3													
4	7		8		9		10		11		12		
5													
6	18		17		16		15		14		13		
7													
8	19		20		21		22		23		24		
9													
10	30		29		28		27		26		25		
11													
12	31		32		33		34		35		36		
13													

I, STEPHEN V. VALLIER in a field survey on JULY, 19 94, do hereby certify that under requirements of P.A. 74, Michigan P.A. of 1970, the corner points mentioned in lines 1 and 2 above were in conformance with regulations and rules therefor as required in the current manual of survey instructions of the United States Department of the Interior, Bureau of Land Management or by a decree of a Court of Law and/or that the corner points mentioned in lines 3, 4 and 5 above were in conformance with the rules of the Michigan Board of Land Surveyors or by a Decree of a Court of Law; established, re-established, monumented, re-monumented, recovered, found as expressed below:

**NOTE: Not more than 4 corners, all in the same town and range, may be recorded on this certificate.**

A. Description of original monument and accessories and/or subsequent restoration:

- 1837 GLO SET 1/4 POST
- 1983 D. SCHELE LIBER 1255, PAGE 474  
FOUND SQUARE BAR
- 1984 C.F. LEWANDOWSKI LIBER 1301, PAGE 590  
FOUND 4" CAST IRON MONUMENT. ACCEPTED POSITION OF CORNER DUE TO HISTORICAL USAGE AND DOCUMENTATION.

B. Description of corner evidence found and/or method applied in restoring or reestablishing corner:


FOUND 4" CAST IRON MONUMENT. ACCEPTED POSITION OF CORNER DUE TO HISTORICAL USAGE AND DOCUMENTATION.

POSITION OF SAID  
 RECORDED CORNER  
 REVIEWED & RATIFIED  
 BY MUSKEGON COUNTY  
 PEER GROUP IN ACCORDANCE  
 WITH P.A. 345, OF 1990

*mar 1, 1994 JW*

C. Description of monument for corner and accessories established to perpetuate locating the position of the corner:

- |                       |                              |
|-----------------------|------------------------------|
| 4" CAST IRON MONUMENT | CENTER LINE GTE JUNCTION BOX |
| N50 DEG. W 38.40'     | NAIL IN POWER POLE           |
| S70 DEG. W 85.76'     | NAIL IN POWER POLE           |
| N70 DEG. E 182.82'±   | NAIL IN POWER POLE           |
| S35 DEG. E 90.30'     |                              |

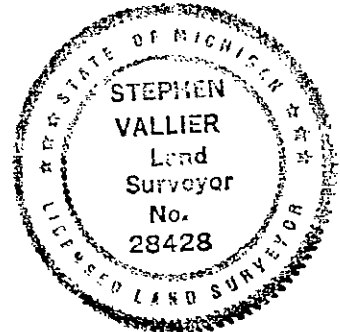

Signed by *Stephen Vallier* Date *Dec 27, 1994*  
 Surveyor's Michigan License No. 28428