

LAND CORNER RECORDATION CERTIFICATE  
Filing Requirement of Act 74, Mich. P.A. 1970

STATE OF MICHIGAN  
COUNTY OF MUSKEGON  
REGISTERED FOR RECORD  
1994 DEC 29 AM 10:10  
C. L. Carter  
REGISTER OF DEEDS

For corners in

MUSKEGON  
(County)

Located In:

Corner Code #

- 1. Public Land Survey      T 9 R 15      M-7
- T    R
- T    R
- T    R
- 2. Property Controlling    S    T    R
- in Section                S    T    R      *Seg. 1 pm*
- 3. Miscellaneous            S    T    R
- Property in Sec.         S    T    R

A1574

Register of Deeds Stamp & File Number

- 4. Lot No. \_\_\_\_\_, Recorded Plat \_\_\_\_\_
- 5. Private Claims \_\_\_\_\_

|    |    |   |    |   |    |   |    |   |    |   |    |   |   |
|----|----|---|----|---|----|---|----|---|----|---|----|---|---|
|    | A  | B | C  | D | E  | F | G  | H | I  | J | K  | L | M |
| 2  | 6  |   | 5  |   | 4  |   | 3  |   | 2  |   | 1  |   |   |
| 3  |    |   |    |   |    |   |    |   |    |   |    |   |   |
| 4  | 7  |   | 8  |   | 9  |   | 10 |   | 11 |   | 12 |   |   |
| 5  |    |   |    |   |    |   |    |   |    |   |    |   |   |
| 6  | 18 |   | 17 |   | 16 |   | 15 |   | 14 |   | 13 |   |   |
| 7  |    |   |    |   |    |   |    |   |    |   |    |   |   |
| 8  | 19 |   | 20 |   | 21 |   | 22 |   | 23 |   | 24 |   |   |
| 9  |    |   |    |   |    |   |    |   |    |   |    |   |   |
| 10 | 30 |   | 29 |   | 28 |   | 27 |   | 26 |   | 25 |   |   |
| 11 |    |   |    |   |    |   |    |   |    |   |    |   |   |
| 12 | 31 |   | 32 |   | 33 |   | 34 |   | 35 |   | 36 |   |   |
| 13 |    |   |    |   |    |   |    |   |    |   |    |   |   |

I, STEPHEN V. VALLIER, in a field survey on JULY, 1994, do hereby certify that under requirements of P.A. 74, Michigan P.A. of 1970, the corner points mentioned in lines 1 and 2 above were in conformance with regulations and rules therefore as required in the current manual of survey instructions of the United States Department of the Interior, Bureau of Land Management or by a decree of a Court of Law and/or that the corner points mentioned in lines 3, 4 and 5 above were in conformance with the rules of the Michigan Board of Land Surveyors or by a Decree of a Court of Law; established, re-established, monumented, re-monumented, recovered, found as expressed below:

NOTE: Not more than 4 corners, all in the same town and range, may be recorded on this certificate.

A. Description of original monument and accessories and/or subsequent restoration:  
1837 GLO SET SECTION CAP

1950's MUSKEGON COUNTY ROAD COMMISSION IRON BOLT

NE 51.30' 12" MAPLE

NW 94.40' 12" MAPLE

1983 FOUND CAPPED IRON D. SCHIELE LIBER 1255, PAGE 474

1984 C.F. LEWANDOWSKI LIBER 1301, PAGE 590 SET 4" x 30"

CAST IRON MONUMENT - WITH COUNTY SURVEY CAP

SURVEY &  
MONUMENTATION

FEB 01 1999

SECTION

B. Description of corner evidence found and/or method applied in restoring or reestablishing corner:

FOUND 4" CAST IRON MONUMENT WITH COUNTY SURVEY CAP  
ACCEPTED POSITION OF EXISTING CORNER DUE TO CONFIRMATION  
OF OLDEST KNOWN WITNESSES

POSITION OF SAID  
RECORDED CORNER  
REVIEWED & RATIFIED  
BY MUSKEGON COUNTY  
PEER GROUP IN ACCORDANCE  
WITH P.A. 345, OF 1990

*Mar 1, 1994 SW*

C. Description of monument for corner and accessories established to perpetuate locating the position of the corner:

4" CAST IRON MONUMENT WITH COUNTY SURVEYOR CAP


N25 DEG. 59.59' 12" USGS

N55 DEG. W 41.64' 12" USGS

S45 DEG. W 48.25' 12" NAIL IN GUY POLE

N60 DEG. E 50.94' 12" NAIL IN 28" MAPLE

S45 DEG. E 45.60' 12" POWER POLE WITH NAIL

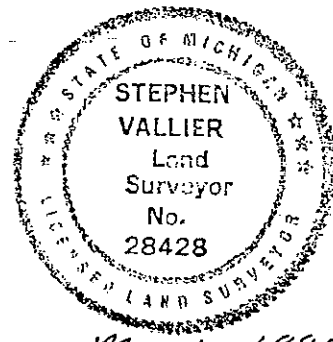

Signed by *Stephen Vallier* Date *Mar 1 1994*  
Surveyor's Michigan License No. 28428