

SURVEY & REMONUMENTATION

LIBER 1810 PAGE 554

APR 28 1995

LAND CORNER RECORDATION CERTIFICATE
Filing Requirement of Act 74, Mich. P.A. 1970

David ...
REGISTER OF DEEDS

STATE OF MICHIGAN
COUNTY OF MUSKEGON
REGISTER OF DEEDS
1991 DEC 29 AM 10:11

For corners in COMMISSION

MUSKEGON (County)	Located In:	Corner Code #
1. Public Land Survey	T <u>9</u> R <u>15</u>	<u>M-11</u>
	T _____ R _____	_____
	T _____ R _____	_____
	T _____ R _____	_____
2. Property Controlling in Section	S _____ T _____ R _____	_____
	S _____ T _____ R _____	_____
3. Miscellaneous Property in Sec.	S _____ T _____ R _____	_____
	S _____ T _____ R _____	_____

A1578

Register of Deeds Stamp & File Number

- 4. Lot No. _____, Recorded Plat _____
- 5. Private Claims _____

	A	B	C	D	E	F	G	H	I	J	K	L	M
2	6		5		4		3		2		1		
3													
4	7		8		9		10		11		12		
5													
6	18		17		16		15		14		13		
7													
8	19		20		21		22		23		24		
9													
10	30		29		28		27		26		25		
11													
12	31		32		33		34		35		36		
13													

STEPHEN V. VALLIER, in a field survey on DECEMBER _____, 19 94, do hereby certify that under requirements of P.A. 74, Michigan P.A. of 1970, the corner points mentioned in lines 1 and 2 above were in conformance with regulations and rules therefore as required in the current manual of survey instructions of the United States Department of the Interior, Bureau of Land Management or by a decree of a Court of Law and/or that the corner points mentioned in lines 3, 4 and 5 above were in conformance with the rules of the Michigan Board of Land Surveyors or by a Decree of a Court of Law; established, re-established, monumented, re-monumented, recovered, found as expressed below:

NOTE: Not more than 4 corners, all in the same town and range, may be recorded on this certificate.

A. Description of original monument and accessories and/or subsequent restoration:

1837 GLO SET SECTION CORNER

1950'S MUSKEGON COUNTY ROAD COMMISSION TIE MAP STONE WITH "X"

1982 C.F. LEWANDOWSKI LBR. 1242 PG. 320 FOUND 1" IRON PIPE (ALONG STONE) - RESET WITH 4" X 30" CAST IRON MONUMENT WITH SURVEY CAP

B. Description of corner evidence found and/or method applied in restoring or reestablishing corner:

FOUND 4" X 30" CAST IRON MONUMENT WITH SURVEY CAP

ACCEPTED POSITION OF EXISTING CORNER DUE TO HISTORICAL USAGE AND CONSISTANT DOCUMENTATION


POSITION OF SAID
RECORDED CORNER
REVIEWED & RATIFIED
BY MUSKEGON COUNTY
REFER TO MAP IN ACCORDANCE
WITH P.A. 345, OF 1990

Oct 4, 1994 sw

C. Description of monument for corner and accessories established to perpetuate locating the position of the corner:

4' CAST IRON MONUMENT WITH SURVEY CAP

- N 20° WEST 74.73' NAIL IN 18" MAPLE
- S 70° EAST 74.60' NAIL IN 30" POPLAR
- S 35° EAST 127.36' NORTHWEST CORNER FRAME BUILDING
- S 45° WEST 42.60' NAIL IN T. POLE

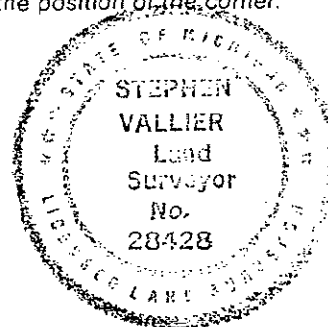

Signed by *Stephen Vallier*

Date *Oct 4, 1994*

Surveyor's Michigan License No. 28428