

**SURVEY &
REMONUMENTATION**

LIBER 1810 PAGE 616

STATE OF MICHIGAN
COUNTY OF MUSKEGON
RECEIVED FOR RECORD

LAND CORNER RECORDATION CERTIFICATE

Filing Requirement of Act 74, Mich. P.A. 1970

1994 DEC 29 AM 10:17

For corners in **MAY 03 1995**

Muskegon (County) **COMMISSION** Located In: **9 14** Corner Code # **A-7**
M-7 ✓
Seg #2

1. Public Land Survey T 9 R 15
T _____ R _____
T _____ R _____
T _____ R _____

2. Property Controlling S _____ T _____ R _____
in Section S _____ T _____ R _____

3. Miscellaneous S _____ T _____ R _____
Property in Sec. S _____ T _____ R _____

Carrie Carter
REGISTER OF DEEDS

A1640

Register of Deeds Stamp & File Number

4. Lot No. _____, Recorded Plat _____
5. Private Claims _____

Stephen V. Vallier in a field survey on **December**, 19 **94**
do hereby certify that under requirements of P.A. 74, Michigan P.A. of 1970, the corner points mentioned in lines 1 and 2 above were in conformance with regulations and rules therefore as required in the current manual of survey instructions of the United States Department of the Interior, Bureau of Land Management or by a decree of a Court of Law and/or that the corner points mentioned in lines 3, 4 and 5 above were in conformance with the rules of the Michigan Board of Land Surveyors or by a Decree of a Court of Law; established, re-established, monumented, re-monumented, recovered, found as expressed below:

A	B	C	D	E	F	G	H	I	J	K	L	M
2	6	5	4	3	2	1						
3												
4	7	8	9	10	11	12						
5												
6	18	17	16	15	14	13						
7												
8	19	20	21	22	23	24						
9												
10	30	29	28	27	26	25						
11												
12	31	32	33	34	35	36						
13												

NOTE: Not more than 4 corners, all in the same town and range, may be recorded on this certificate.

A. Description of original monument and accessories and/or subsequent restoration:

- 1837 GLO set corner
- 1950's M.C.R.C. Tie Map - Iron Bolt
- 1983 C.F. Lewandowski - L.C.R.C. Liber 1318 Page 916 Found 1" bolt. Reset with 4" cast iron monument with County Survey Cap.

B. Description of corner evidence found and/or method applied in restoring or reestablishing corner:


Found 4" cast iron monument w/County Survey Cap.
Accepted position of corner due to Historical usage and consistent documentation.

POSITION OF SAID
RECORDED CORNER
REVIEWED & RATIFIED
BY MUSKEGON COUNTY
PEER GROUP IN ACCORDANCE
WITH P.A. 345, OF 1990

Nov 8 1994 SL

C. Description of monument for corner and accessories established to perpetuate locating the position of the corner:
4" cast iron monument with County Survey Cap.

- N 30 deg E 59.59' USGS
- S 45 deg E 45.60' Power Pole with nail
- N 40 deg W 41.64' USGS
- N 50 deg E 51.30' 12" Maple with nail

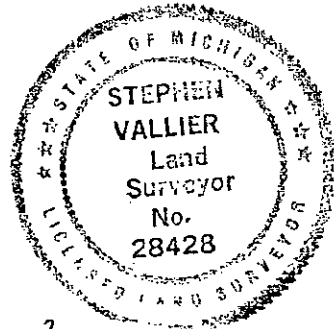

Signed by *Stephen Vallier* Date *Dec 27, 1994*
Surveyor's Michigan License No. 28428