


MUSKEGON Co

T9N, R16W

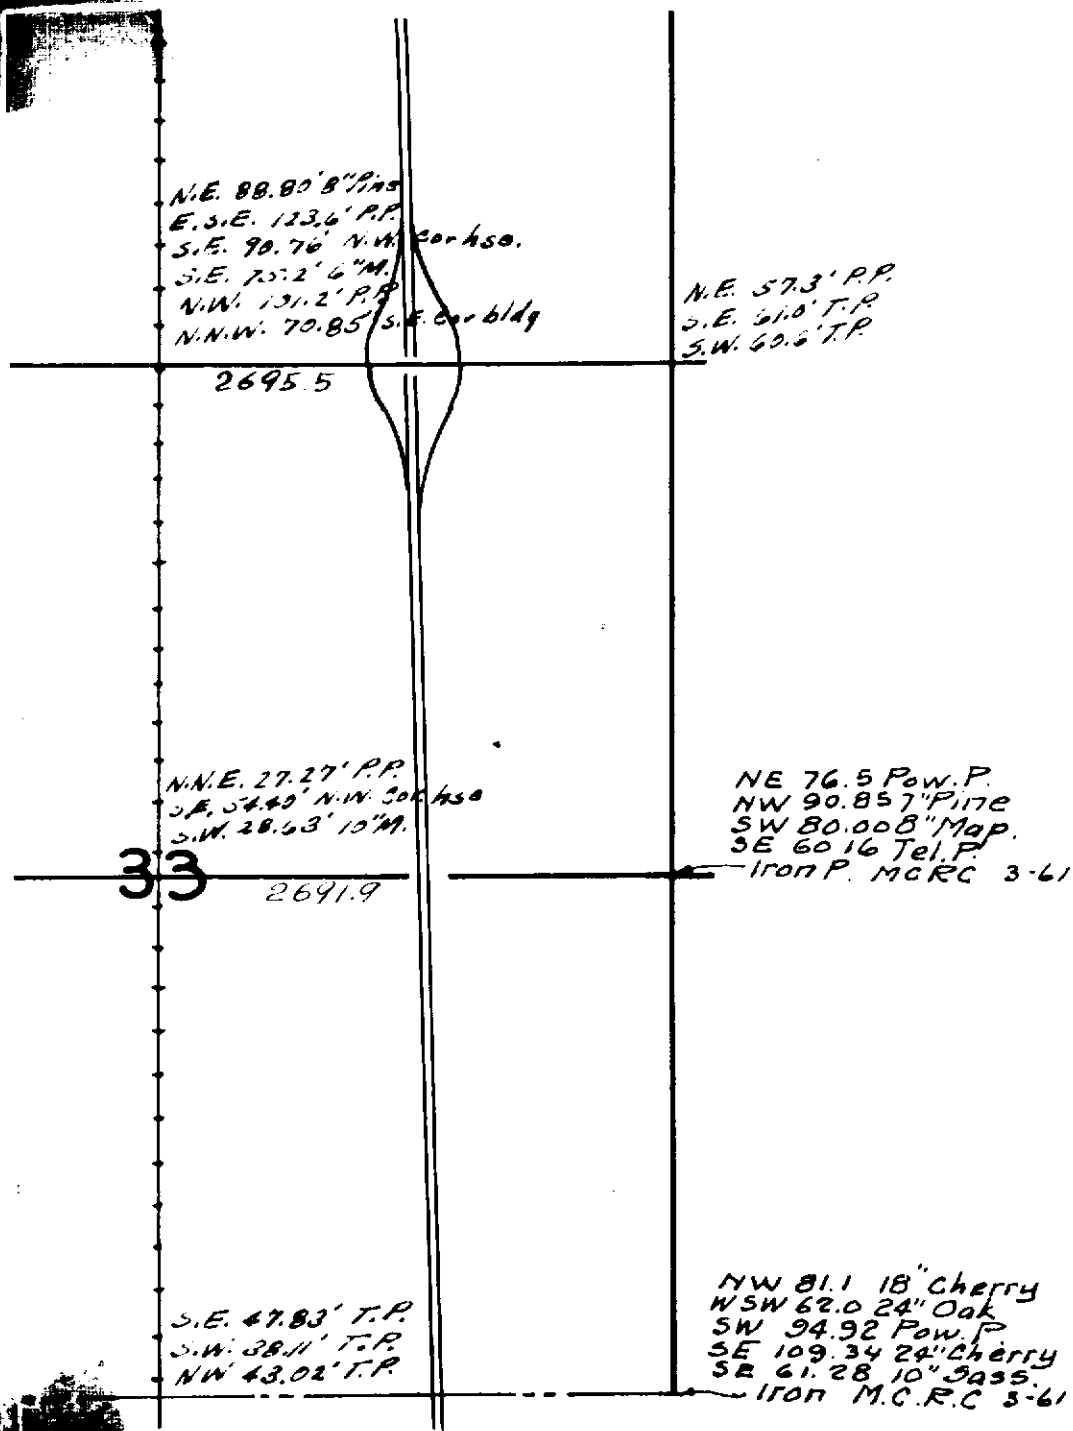

T-9-N, R-16-W