MUSKEGON Co

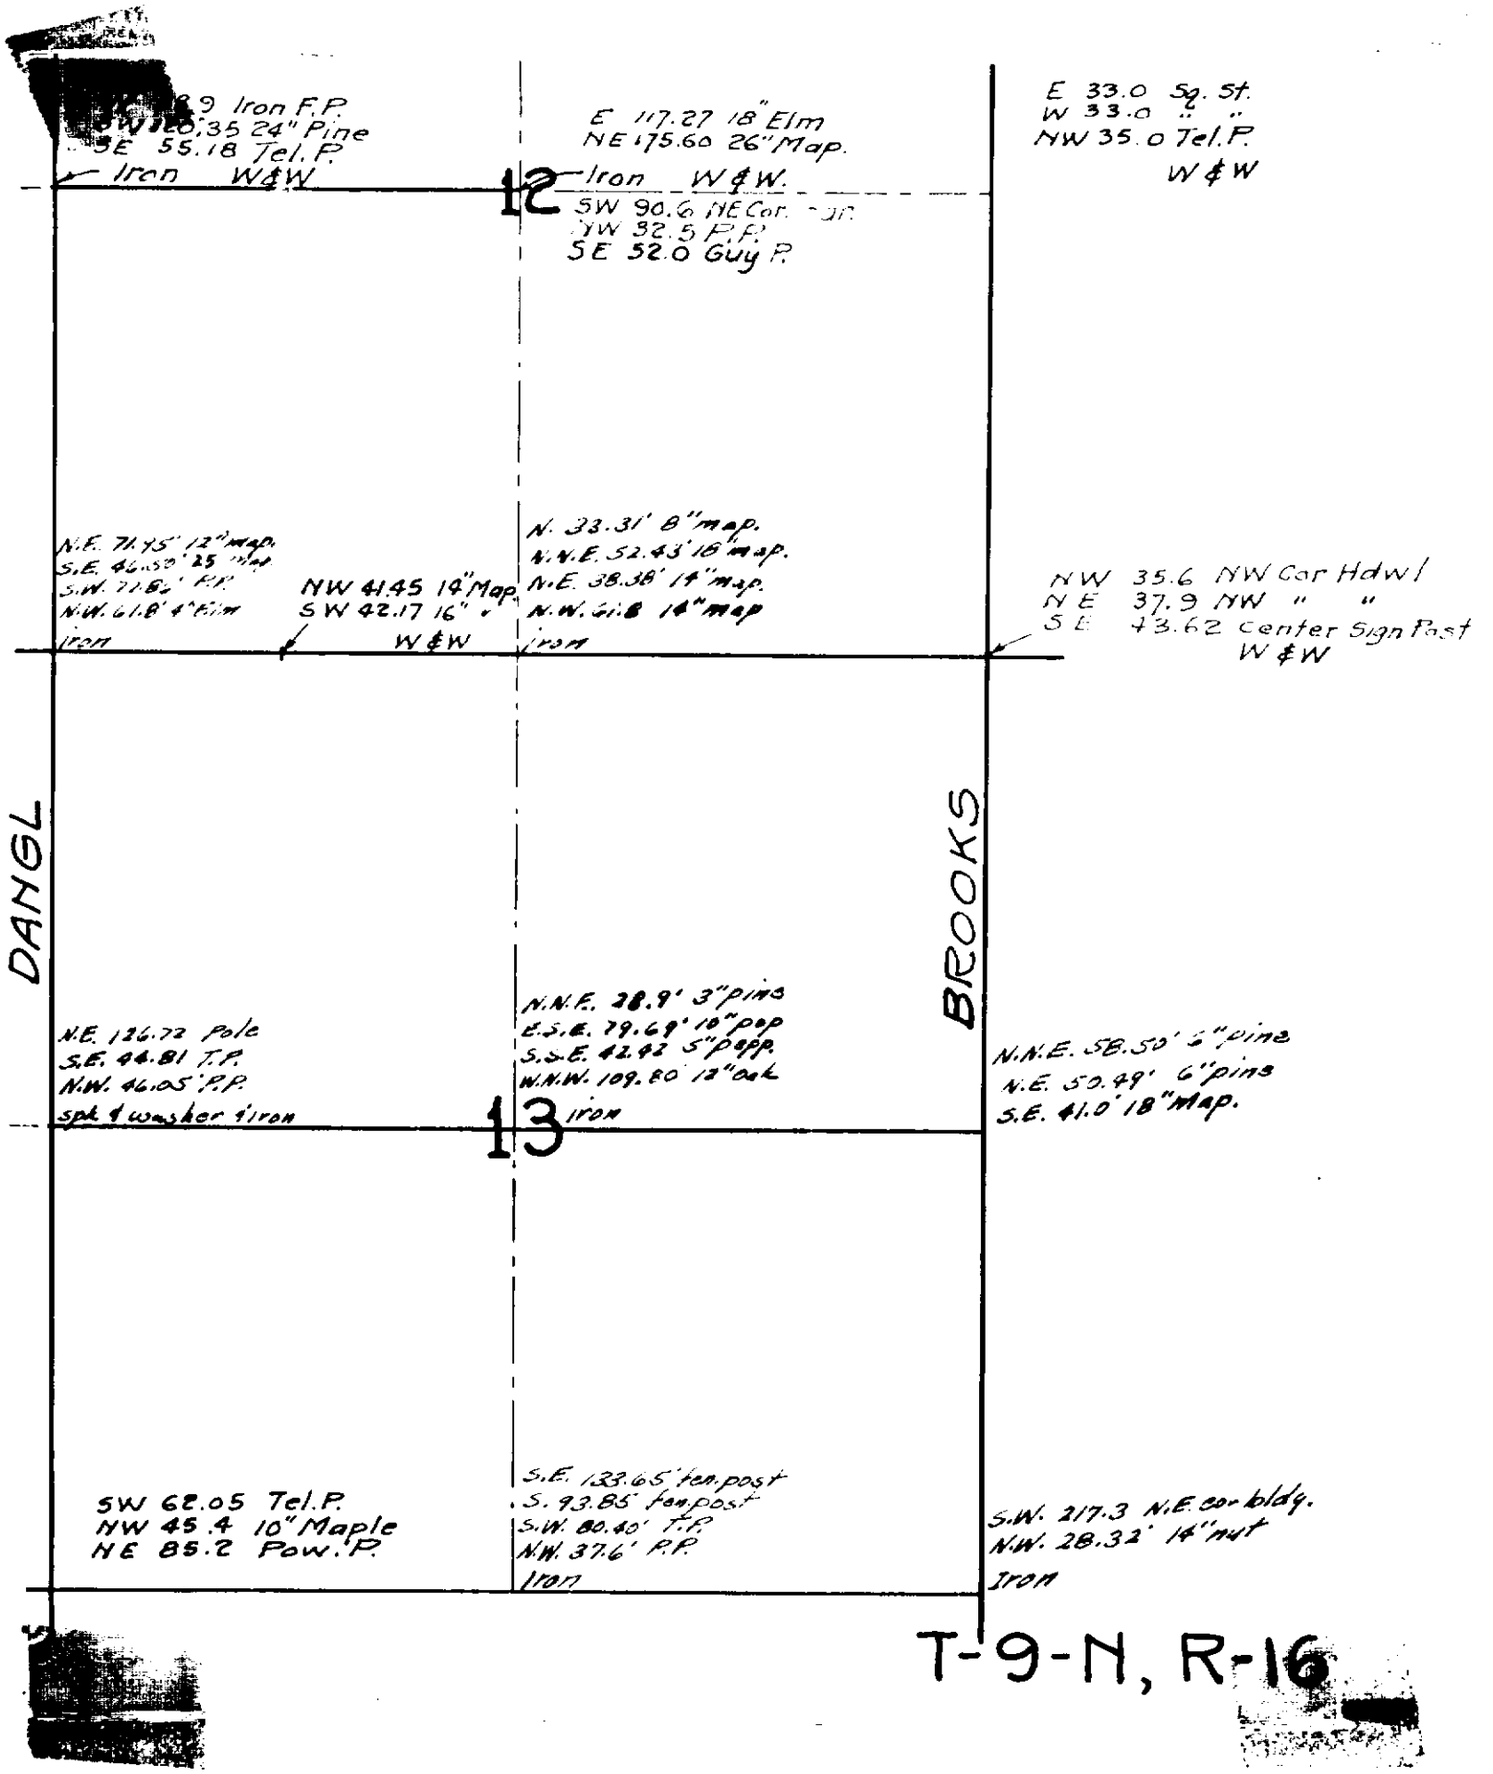

T-9-N, R-16