MUSKEGON Co
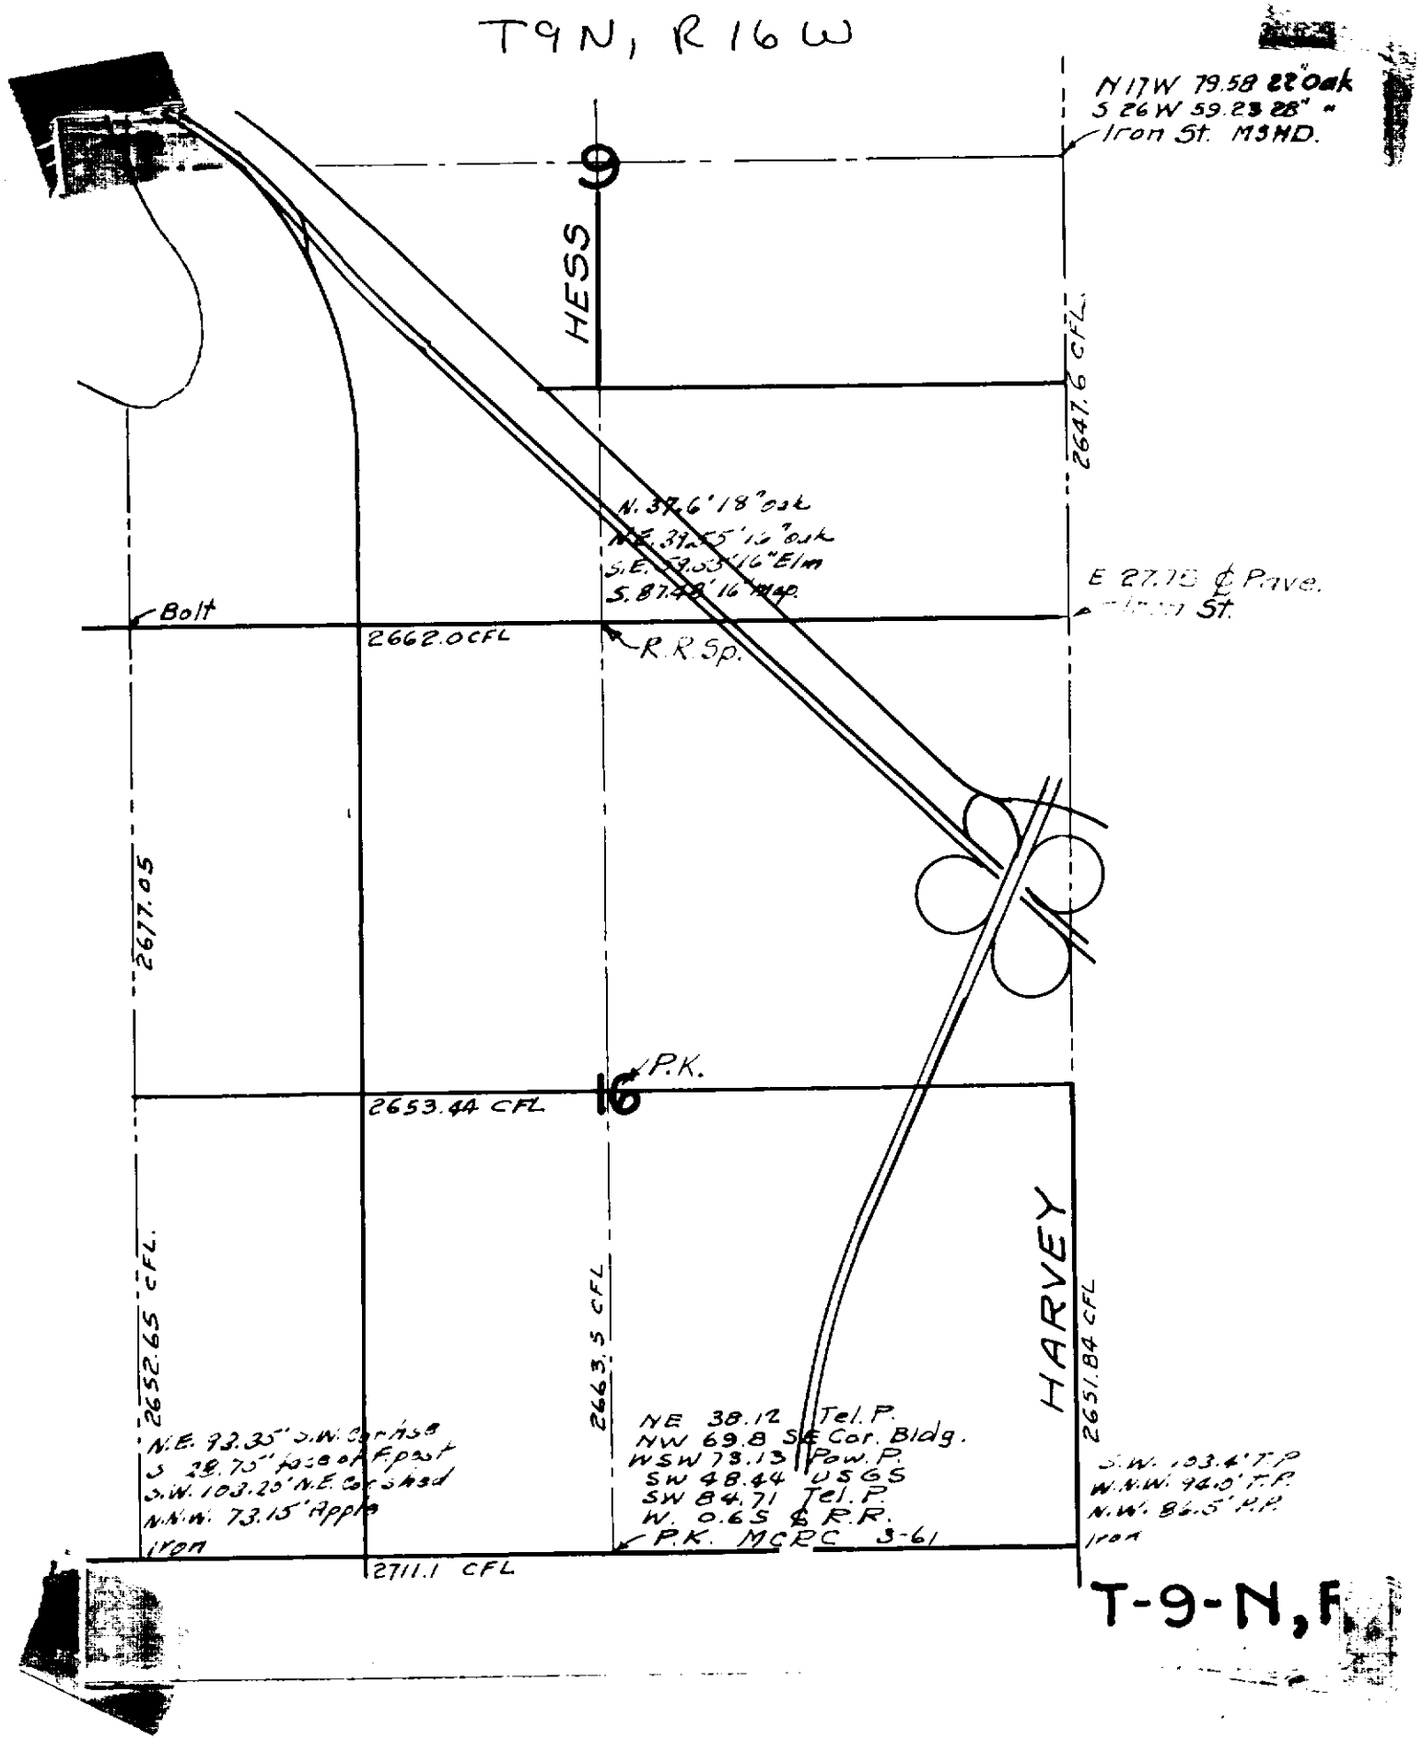
T9N, R16W