

SURVEY & REMONUMENTATION

LIBEP 2052 PAGE 615

APR 03 1998

LAND CORNER RECORDATION CERTIFICATE
Filing Requirement of Act 74, Mich. P.A. 1970

STATE OF MICHIGAN
COUNTY OF MUSKEGON
RECEIVED FOR RECORD

1997 DEC 30 PM 3:23

Carrie Carter
REGISTER OF DEEDS

SECTION
For corners in
Muskegon
(County)

Located In: Corner Code #

1. Public Land Survey	T 9N R 16W	E-6
	T _____ R _____	_____
	T _____ R _____	_____
	T _____ R _____	_____
2. Property Controlling in Section	S _____ T _____ R _____	_____
	S _____ T _____ R _____	_____
3. Miscellaneous Property in Sec.	S _____ T _____ R _____	_____
	S _____ T _____ R _____	_____

Register of Deeds Stamp & File Number

4. Lot No. _____, Recorded Plat _____
5. Private Claims _____

	A	B	C	D	E	F	G	H	I	J	K	L	M
2	6	5	4	3	2	1							
3													
4	7	8	9	10	11	12							
5													
6	18	17	16	15	14	13							
7													
8	19	20	21	22	23	24							
9													
10	30	29	28	27	26	25							
11													
12	31	32	33	34	35	36							
13													

I, Stanley H. Shackelford, PS, in a field survey on April 28, 1997, do hereby certify that under requirements of P.A. 74, Michigan P.A. of 1970, the corner points mentioned in lines 1 and 2 above were in conformance with regulations and rules therefore as required in the current manual of survey instructions of the United States Department of the Interior, Bureau of Land Management or by a decree of a Court of Law and/or that the corner points mentioned in lines 3, 4 and 5 above were in conformance with the rules of the Michigan Board of Land Surveyors or by a Decree of a Court of Law; established, re-established, monumented, re-monumented, recovered, found as expressed below:

NOTE: Not more than 4 corners, all in the same town and range, may be recorded on this certificate.

A. Description of original monument and accessories and/or subsequent restoration:

E-6 GLO MAY 1837 SET QUARTER SECTION POST S47°E 3.96' 12" BIRCH S47°W 13.86' 12" BIRCH

1940'S Muskegon County Survey Recprds Page 89 and 271 Iron Pipe
S.W. 55.70' 6" Apple
S.W. 20.20' Telephone Pole
N.E. 28.00' Fence Post

(See Attached)

B. Description of corner evidence found and/or method applied in restoring or reestablishing corner:

E-6 FOUND 2 3/4" X 30" CAST IRON COUNTY SURVEY MONUMENT IN MONUMENT BOX

N. 70° W	69.86'	Found Spike South Side 24" Oak
S. 10° W	24.74'	Found Spike East Side Power Pole
N.	29.20'	Found Spike West Side Telephone Pole
S.	33.00'	Found Concrete Monument


POSITION OF SAID
RECORDED CORNER
REVIEWED & VERIFIED
BY MUSKEGON COUNTY
PEER GROUP IN ACCORDANCE
WITH P.A. 345, OF 1990

SW
11/4/97

C. Description of monument for corner and accessories established to perpetuate locating the position of the corner:

E-8 FOUND 2 3/4" X 30" CAST IRON COUNTY SURVEY MONUMENT IN MONUMENT BOX With County Surveyor

N. 70° W	69.86'	Found Spike South Side 24" Oak
S. 10° W	24.74'	Found Spike East Side Power Pole
N.	29.20'	Found Spike West Side Telephone Pole
S.	33.00'	Found Concrete Monument
S. 63°W	47.14'	Set 1/2" Capped Rod
S. 35°E	53.36'	Set Spike Southwest Side 6" Oak

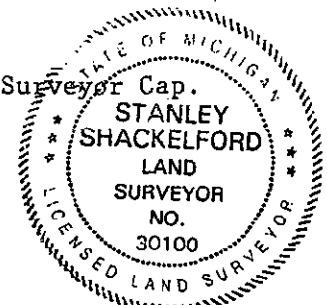

Signed by *Stanley H. Shackelford* Date *December 29 1997*
Surveyor's Michigan License No. 30100

A1928

T9N R16W E-6

**SURVEY &
REMONUMENTATION**

APR 03 1998

LIBEP **2052** PAGE **616**

SECTION

1950 Muskegon County Road Commission Witness Book-3/4" Iron

S.	24.77'	Power Pole
N. NE	82.05'	West House Corner
N.	29.30'	Telephone Pole
W. NW	70.23'	18" Oak
S.	33.00"	Concrete Monument

1981 L1210, P128 Muskegon County Records - Set 3/4" Iron in Monument Box

N.10°E	82.00'	S.W. Corner Frame House
N.	29.20'	Power/Telephone Pole
N.60°W	69.86'	28" Oak
S.10°W	24.74'	Power Pole Corner on Fence line South

1989 L1493, P740 Muskegon County Records Found 3/4" Pipe in Monument Box
Set 2 3/4" X 30" Cast Iron County Survey Monument in Monument Box

N. 60°W	69.86'	24" Oak
S. 10°W	24.74'	Power Pole
N.	29.20'	Telephone Pole
S	33.00'	Concrete Monument