

**SURVEY & REMONUMENTATION**

LIBER **2052** PAGE **606**

STATE OF MICHIGAN  
COUNTY OF MUSKEGON  
RECEIVED FOR RECORD

**APR 03 1998**

**LAND CORNER RECORDATION CERTIFICATE**  
Filing Requirement of Act 74, Mich. P.A. 1970

1997 DEC 30 PM 3:23


For corners in  
Muskegon  
**SECTION**  
(County)

	Located In:		Corner Code #
	9N	16W	
1. Public Land Survey	T	R	F-5
	T	R	
	T	R	
	T	R	
2. Property Controlling in Section	S	T	R
	S	T	R
3. Miscellaneous Property in Sec.	S	T	R
	S	T	R

*Carrie Carter*  
REGISTER OF DEEDS

Register of Deeds Stamp & File Number

4. Lot No. \_\_\_\_\_, Recorded Plat \_\_\_\_\_  
5. Private Claims \_\_\_\_\_

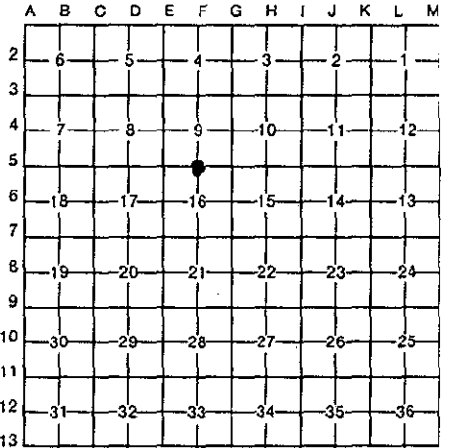

Stephen V. Vallier P.S. December 5, 97

I, \_\_\_\_\_, in a field survey on \_\_\_\_\_, 19\_\_\_\_, do hereby certify that under requirements of P.A. 74, Michigan P.A. of 1970, the corner points mentioned in lines 1 and 2 above were in conformance with regulations and rules therefore as required in the current manual of survey instructions of the United States Department of the Interior, Bureau of Land Management or by a decree of a Court of Law and/or that the corner points mentioned in lines 3, 4 and 5 above were in conformance with the rules of the Michigan Board of Land Surveyors or by a Decree of a Court of Law; established, re-established, monumented, re-monumented, recovered, found as expressed below:

**NOTE: Not more than 4 corners, all in the same town and range, may be recorded on this certificate.**

A. Description of original monument and accessories and/or subsequent restoration:

- 1837 G.L.O. Set Post J. Mullett  
North 56° East 16 Links 6 Inch Hemlock  
South 22° East 10 Links 8 Inch Hemlock
- 1885 Muskegon County Surveyor - Van Zlingszen
- 1950 Plat of Macomb Subdivision
- 1989 L.C.R.C. Liber 1500, Page 596.  
"X" Set 3 3/4 Inch By 30 Inch Cast Iron Monument With County Surveyor Cap  
Found P.K. Nail over 3/4 Inch By 18 Inch Iron Pipe  
North 72° East 65.30 Feet Power Pole

Iron Shown - Assumed G.L.O. perpetuation.  
Westshore Engineering & Surveying, Inc.  
Found Nail West Side (See Attached)

B. Description of corner evidence found and/or method applied in restoring or reestablishing corner:

Found 4 Inch By 30 Inch Cast Iron Monument with County Surveyor Cap.  
Found consistent Documentation and Evidence From 1885 Verifying Location of Corner.

POSITION OF SAID  
RECORDED CORNER  
REVIEWED & RATIFIED  
BY MUSKEGON COUNTY  
PEER GROUP IN ACCORDANCE  
WITH P.A. 305, OF 1980


*sw 11/4/97*

C. Description of monument for corner and accessories established to perpetuate locating the position of the corner:

North 72° East	65.30 Feet	Power Pole	Found Nail West Side
North 70° West	92.10 Feet	Power Pole	Found Nail South Side
South 03° West	38.88 Feet	Concrete Right-Of-Way Marker	
South 47° West	47.75 Feet	16 Inch Aspen	Found Nail South Side
South 38° West		House No. 1203	Found in Northeast Corner

Signed by \_\_\_\_\_

*Stephen Vallier*

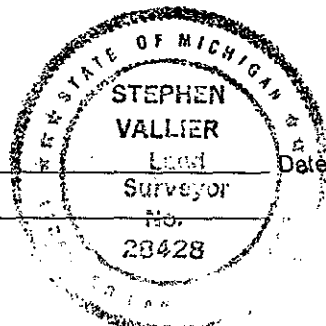

December 15, 1997

Surveyor's Michigan License No. **28428**

*A1923*

**SURVEY &  
REMONUMENTATION**

T9N R16W F-5

LIBEP **2052** PAGE **607**

**APR 03 1998**

**SECTION**

North 72° East	65.30 Feet	Power Pole	Found Nail West Side
North 70° West	92.10 Feet	Power Pole	Found Nail South Side
South 03° West	38.88 Feet	Concrete Right-Of-Way Marker	
South 47° West	47.75 Feet	16 Inch Aspen	Found Nail South Side
South 38° West	95.39 Feet	House No. 1203	