

SURVEY & REMONUMENTATION

APR 03 1998

LIBER 2052 PAGE 586

LAND CORNER RECORDATION CERTIFICATE
Filing Requirement of Act 74, Mich. P.A. 1970

STATE OF MICHIGAN
COUNTY OF MUSKEGON
RECEIVED FOR DEEDS

1997 DEC 30 PM 3:21

Carrie Carter
REGISTER OF DEEDS

SECTION

For corners in

<u>Muskegon</u> (County)	Located In:	Corner Code #:
1. Public Land Survey	T <u>9N</u> R <u>16W</u>	<u>G-6</u>
	T _____ R _____	_____
	T _____ R _____	_____
	T _____ R _____	_____
2. Property Controlling in Section	S _____ T _____ R _____	_____
	S _____ T _____ R _____	_____
3. Miscellaneous Property in Sec.	S _____ T _____ R _____	_____
	S _____ T _____ R _____	_____

Register of Deeds Stamp & File Number

4. Lot No. _____, Recorded Plat _____
5. Private Claims _____

	A	B	C	D	E	F	G	H	I	J	K	L	M
2	6		5		4		3		2		1		
3													
4	7		8		9		10		11		12		
5													
6	18		17		16		15		14		13		
7													
8	19		20		21		22		23		24		
9													
10	30		29		28		27		26		25		
11													
12	31		32		33		34		35		36		
13													

I, Stephen V. Vallier P.S., in a field survey on November 4, 1997, do hereby certify that under requirements of P.A. 74, Michigan P.A. of 1970, the corner points mentioned in lines 1 and 2 above were in conformance with regulations and rules therefore as required in the current manual of survey instructions of the United States Department of the Interior, Bureau of Land Management or by a decree of a Court of Law and/or that the corner points mentioned in lines 3, 4 and 5 above were in conformance with the rules of the Michigan Board of Land Surveyors or by a Decree of a Court of Law; established, re-established, monumented, re-monumented, recovered, found as expressed below:

NOTE: Not more than 4 corners, all in the same town and range, may be recorded on this certificate.

A. Description of original monument and accessories and/or subsequent restoration:

- 1837 G.L.O. Set Post - J. Mullett
North 61° West 16 Links 20 Inch Beech
South 33° East 40 Links 10 Inch Hemlock
- 1885 County Survey records - Van Zlingszen
Origin and Source Not Determined - Iron Reflector as Monument - No Witnesses
- 1989 L.C.R.C. Liber 1500, Page 594 - S. Shackelford 14 Inch Boat Spike. Found in Monument Box
Reset 2 3/4 Inch By 30 Inch Cast Iron Monument

(See Attached)

B. Description of corner evidence found and/or method applied in restoring or reestablishing corner:

Found 2 3/4 Inch By 30 Inch Cast Iron Monument With County Surveyor Cap Inside Monument Box.
Historical Usage and Documentation Support Position Of Corner.


	1997	1885
Measurement G-6 To G-6	2651.89 Feet	2650.0 Feet

POSITION OF SAID
RECORDED CORNER
REVIEWED & RATIFIED
BY MUSKEGON COUNTY
PEER GROUP IN ACCORDANCE
WITH P.A. 345, OF 1990

sw 11/4/97

C. Description of monument for corner and accessories established to perpetuate locating the position of the corner:

- | | | | |
|--|-------------|--------------------|--------------------------------|
| 2 3/4 x 30 Inch Cast Iron Monument with County Surveyor Cap in Monument Box. | | | |
| North 85° East | 67.86 Feet | Fire Hydrant | Centerline |
| South 45° West | 92.04 Feet | Power & Light Pole | Found Nail Southeast Side |
| South 10° East | 190.16 Feet | Power Pole | Set Nail West Side |
| North 30° East | 109.80 Feet | Power Pole | Found Nail East Side |
| North 37° West | 48.69 Feet | C.B. Rim | East Corner |
| North 55° West | 103.13 Feet | Light Pole | Found P.K. Nail Southwest Side |

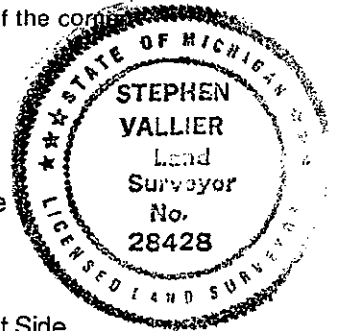

Signed by *Stephen Vallier* Date December 15, 1997
Surveyor's Michigan License No. 28428

A1907

T9N R16W G-6

SURVEY &
REMONUMENTATION

APR 03 1998

SECTION

LIBEP 2052 PAGE 587

North 27° East	109.89 Feet	Power Pole	Found Nail Northeast Side
South 15° East	75.30 Feet	Concrete Hardware	Northwest Corner
South 22° West	75.23 Feet	Concrete Hardware	Northeast Corner
South 45° West	92.07 Feet	Power Pole	Found Nail East Side
North 50° West	111.30 Feet	14 Inch Maple	Found Nail West Side