

APR 03 1998

LAND CORNER RECORDATION CERTIFICATE
Filing Requirement of Act 74, Mich. P.A. 1970

STATE OF MICHIGAN
COUNTY OF MUSKEGON
RECEIVED FOR RECORD

1997 DEC 30 PM 3:23

Carrie Carter
REGISTER OF DEEDS

SECTION
For corners in Muskegon

Table with columns: Located In: (County), Corner Code ##, 9N, 16W, G-8. Rows include Public Land Survey, Property Controlling in Section, Miscellaneous Property in Sec., Lot No., and Private Claims.

Register of Deeds Stamp & File Number

Grid table with columns A-M and rows 2-13. Cell (8, G) contains a small circle symbol.

I, Stephen V. Vallier P.S., in a field survey on November 4, 1997, do hereby certify that under requirements of P.A. 74, Michigan P.A. of 1970, the corner points mentioned in lines 1 and 2 above were in conformance with regulations and rules therefore as required in the current manual of survey instructions of the United States Department of the Interior, Bureau of Land Management or by a decree of a Court of Law and/or that the corner points mentioned in lines 3, 4 and 5 above were in conformance with the rules of the Michigan Board of Land Surveyors or by a Decree of a Court of Law; established, re-established, monumented, re-monumented, recovered, found as expressed below:

NOTE: Not more than 4 corners, all in the same town and range, may be recorded on this certificate.

A. Description of original monument and accessories and/or subsequent restoration:

- 1837 G.L.O. Set Post J. Mullett
North 56° West 8 Links 36 Inch Hemlock
North 75° West 23 Links 12 Inch Hemlock
1985 L.C.R.C. Liber 1230, Page 478 D. Sandel Found Iron in Monumentation Box
1988 L.C.R.C. Liber 1263, Page 299 C.F. Lewandowski Section Cast Iron County Surveyor Monument
1992 L.C.R.C. Liber 1606, Page 709 J. Lazarock M.C.R.C.
Reset County Surveyor Monument in Monument Box Due to Road Construction.

(See Attached)

B. Description of corner evidence found and/or method applied in restoring or reestablishing corner:

Found County Surveyor Monument 4 Inch By 30 Inch Placed in Monument Box With County Surveyor Legend. Source and Origin Undetermined But Appears Corner Was Set By Single Proportionate Measure. Historical Usage and Known Documentation Verify Position of Corner

South 60° West 113.04 Feet 30 Inch Maple

Found Nail

POSITION OF SAID RECORDED CORNER REVIEWED & RATIFIED BY MUSKEGON COUNTY PEER GROUP IN ACCORDANCE WITH P.A. 345, OF 1990


500 11/14/97

C. Description of monument for corner and accessories established to perpetuate locating the position of the corner:

4 Inch by 30 Inch Cast Iron Monument With County Surveyor Cap Placed In Monument Box.

- South 52° East 72.50 Feet Signal Pole Bolt In Northeast Side
North 52° West 87.15 Feet Signal Pole Bolt in Southwest Side
North 35° East 79.56 Feet Centerline Fire Hydrant Bolt in Southeast Corner
South 40° West 73.68 Feet Centerline Fire Hydrant
South 40° East 36.36 Feet 1 1/2 Inch Well
South 60° West 113.04 Feet 30 Inch Maple Found Nail Southwest Side

Signed by Stephen V. Vallier
Surveyor's Michigan License No. 28428

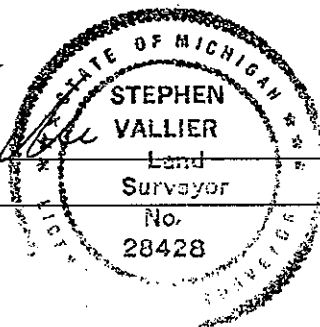

Date December 15, 1997

A1927

SURVEY &
REMONUMENTATION

APR 03 1998

SECTION

T9M R16W G-8

LIBEP 2052 PAGE 614

South 32° West 153.71 Feet
South 62° West 113.12 Feet
North 52° East 93.20 Feet
North 30° West 111.10 Feet

24 Inch Willow
30 Inch Maple
12 Inch Pine
8 Inch Pine

Stephen V. Walsh

