

JAN 31 2001

LIBER 3121 PAGE 892
LAND CORNER RECORDATION CERTIFICATE
Filing Requirement of Act 74, Mich. P.A. 1970

STATE OF MICHIGAN
COUNTY OF MUSKEGON
RECEIVED FOR RECORD

2001 DEC 21 PM 1:00

Mark Fischell
REGISTER OF DEEDS

SECTION
For corners in

<u>Muskegon</u> (County)	Located In:	Corner Code #
1. Public Land Survey	T <u>10N</u> R <u>14W</u>	<u>E-4</u>
	T _____ R _____	_____
	T _____ R _____	_____
	T _____ R _____	_____
2. Property Controlling in Section	S _____ T _____ R _____	_____
	S _____ T _____ R _____	_____
3. Miscellaneous Property in Sec.	S _____ T _____ R _____	_____
	S _____ T _____ R _____	_____

Register of Deeds Stamp & File Number

4. Lot No. _____, Recorded Plat _____
5. Private Claims _____

I, Stephen V. Vallier, in a field survey on October 3, 2000 do hereby state that under requirements of P.A. 74, Michigan P.A. of 1970, the corner points mentioned in lines 1 and 2 above were in conformance with regulations and rules therefore as required in the current manual of survey instructions of the United States Department of the Interior, Bureau of Land Management or by a decree of a Court of Law and /or that the corner points mentioned in lines 3, 4 and 5 above were in conformance with the rules of the Michigan Board of Land Surveyors or by a Decree of a Court of Law; established, re-established, monumented, recovered, found as expressed below:

NOTE: Not more than 2 corners, all in the same town and range, may be recorded on this certificate.

A	B	C	D	E	F	G	H	I	J	K	L	M
1												
2	6	5	4	3	2	1						
3												
4	7	8	9	10	11	12						
5												
6	18	17	16	15	14	13						
7												
8	19	20	21	22	23	24						
9												
10	30	29	28	27	26	25						
11												
12	31	32	33	34	35	36						
13												

A. Description of original monument and accessories and/or subsequent restoration:

1837 John Mullett (G.L.O.) set a post.

S	50°	E	20" Pine	9 Links
S	23°	W	9" Pine	12 Links

1975 Muskegon County Road Commission - John Lazarock found a 1" iron pipe recorded in L.C.R.C., L. 1064, Pg. 550.

ESE	32.75'	5" Poplar
ESE	40.32'	5" Pine
SE	57.06'	12" Pine
NE	36.90'	6" Poplar

POSITION OF SAID *Replaced*
RECORDED CORNER *9/15/00*
REVIEWED & RATIFIED *SV*
BY MUSKEGON COUNTY
PEER GROUP IN ACCORDANCE
WITH P.A. 345, OF 1990

B. Description of corner evidence found and/or method applied in restoring or reestablishing corner:


In October 2000, a 3/4" iron pipe was found in a monument box. Subject corner is 5' within halfway split of mile.

Location of the existing corner was accepted due to the historical usage and documentation.

C. Description of monument for corner and accessories established to perpetuate locating the position of the corner:

Replaced the 3/4" iron pipe with a 2 3/4" x 30" cast-iron monument containing a "County Survey" cap (No. 28428) in a monument box.

N 78° E	48.10'	8" White Pine	Found nail
N 37° E	69.08'	15" Maple	Found nail
S 72° E	51.36'	8" Dead Pine	Found nail
S 67° W	39.82'	10" Dead Poplar	Found nail
N 40° W	58.00'	6" Jack Pine	Found nail

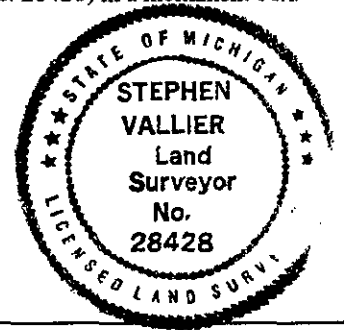

Signed by *Stephen Vallier*
Surveyor's Michigan License No. 28428

Date 12/14/00
FORM APPROVED BY MICHIGAN STATE BOARD OF PROFESSIONAL SURVEYORS, JAN. 28, 1971
REVISED MAY 14, 1977
REVISED JAN., 1981
REVISED OCT., 1992

A2174