

JAN 31 2001

LAND CORNER RECORDATION CERTIFICATE  
Filing Requirement of Act 74, Mich. P.A. 1970

STATE OF MICHIGAN  
COUNTY OF MUSKEGON  
RECEIVED FOR RECORD

2001 DEC 21 PM 1:00

or corners SECTION

Muskegon	Located In:	Corner Code #
(County)		
1. Public Land Survey	T 10N R 14W	E-6
	T _____ R _____	_____
	T _____ R _____	_____
	T _____ R _____	_____
2. Property Controlling in Section	S _____ T _____ R _____	_____
	S _____ T _____ R _____	_____
3. Miscellaneous Property in Sec.	S _____ T _____ R _____	_____
	S _____ T _____ R _____	_____

*Mark Fairchild*  
REGISTER OF DEEDS

Register of Deeds Stamp & File Number

4. Lot No. \_\_\_\_\_, Recorded Plat \_\_\_\_\_

5. Private Claims \_\_\_\_\_

I, Stephen V. Vallier, in a field survey on September, 2000 do hereby state that under requirements of P.A. 74, Michigan P.A. of 1970, the corner points mentioned in lines 1 and 2 above were in conformance with regulations and rules therefore as required in the current manual of survey instructions of the United States Department of the Interior, Bureau of Land Management or by a decree of a Court of Law and /or that the corner points mentioned in lines 3, 4 and 5 above were in conformance with the rules of the Michigan Board of Land Surveyors or by a Decree of a Court of Law; established, re-established, monumented, recovered, found as expressed below:

A	B	C	D	E	F	G	H	I	J	K	L
1											
2	6		5		4		3		2		1
3											
4	7		8		9		10		11		12
5											
6	18		17		16		15		14		13
7											
8	19		20		21		22		23		24
9											
10	30		29		28		27		26		25
11											
12	31		32		33		34		35		36
13											

NOTE: Not more than 2 corners, all in the same town and range, may be recorded on this certificate.

A. Description of original monument and accessories and/or subsequent restoration:

- 1837 John Mullett (G.L.O.) set post.  
S 01°E Ash 17.60 Links
- 1868 Consumer Power Company's survey Plan, No. 3314:  
East P. Pole 84.0'  
S 80° W 18" Maple 57.4'  
S 50° W 4" Twin Apple 77.3'

POSITION OF SAID  
RECORDED CORNER  
REVIEWED & RATIFIED  
BY MUSKEGON COUNTY  
PEER GROUP IN ACCORDANCE  
WITH P.A. 345, OF 1990

*Reviewed 9/5/00*

B. Description of corner evidence found and/or method applied in restoring or reestablishing corner:


In September 2000, a 3/4" x 18" iron pipe was found in the centerline of Moorland Road on the occupation line to the East. Position was verified by 1968 witness to power pole.

Position of the existing corner was accepted due to historical usage and documentation.

C. Description of monument for corner and accessories established to perpetuate locating the position of the corner:

The found 3/4" x 18" iron pipe was replaced with a 2 3/4" x 30" cast-iron monument containing a "County Survey Cap," No. 28428

- N 33° W 36.46' 8" Poplar Found nail
- S 55° W 42.64' 6" Poplar Set 16 D nail on East side
- N 60° E 46.09' 8" Poplar Found nail
- S 82° E 84.29' Power Pole Set 16D nail on North side

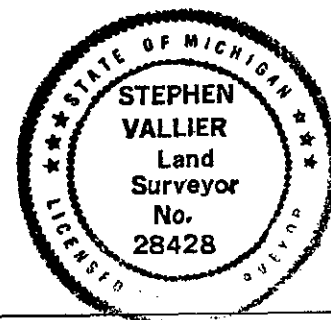

Signed by *Stephen Vallier*  
Surveyor's Michigan License No. 28428

Date 12/19/06  
FORM APPROVED BY MICHIGAN STATE BOARD OF PROFESSIONAL SURVEYORS, JAN. 28,  
REVISED MAY 14,  
REVISED JAN.,  
REVISED OCT.,

A2172